IREDELL COUNTY HEALTH DEPARTMENT

STATESVILLE 704-878-5305 MOORESVILLE 704-664-5281

IMPROVEMENT PERMIT / AUTHORIZATION TO CONSTRUCT / OPERATION PERMIT / EXISTING SYSTEM INSPECTION

PERMIT# 07915 PIN# 4625941684 4635-23-2314 DATE Aug. 10, '98

OWNER OR CONTRACTOR Crescent Resources Inc // Peter Bld PHONE: Business Home

ADDRESS P.O. Box 1003, Charlotte

LOCATION Brawley Sch Rd. TL The Pointe Dr. Queen Anne Circle to Vineyard Dr. to Falmouth Rd on Right before Barnstable Ct.

SUBDIVISION The Pointe BLOCK / SECTION 1A LOT 95 LOT AREA 37,848 SITE CLASS. PS DESIGN FLOW 480gpd L.T.A.R. 125-.3

Septic Tank: 1000 1500 Gallons; STB 312 Date

Pump Tank: 1000 Gallons; PT 29 Date

Pump Make: MYERS Model ME3F51 Serial No.

Nitrification Field: No Fields 1 Square Feet 1200 + Linear Feet 400 +

No Lines 5@80'+ Trench Width 36" Max Trench Bottom Depth 36" Gravel Depth N/A

☑ New System ☐ Repair System Type: I, II, (III) IV, V, VI

System Description: pumped-pm - 25% Reduction

Repair System Description: pumped-pm / LPP 25-50% Red.

Maintenance Agreement Required: ☐ Yes ☑ No

☑ House/Mod. Home No. Bedrooms 4

☐ Mobile Home No. Bathrooms 4

☐ Business No. Employees

☐ Other

☐ Slab ☑ Crawl Space ☐ Basement w/plumbing ☐ Basement wo/plumbing


Water Supply: ☐ Individual ☑ Public ☐ Community

Comments/Conditions: Remove old barns, terraces.
* ONE Inspection/Observation port per Lateral.


Comments/Conditions: 2-16-99 - Home & Site plan reviewed; appears in compliance w/ I.P.
12/7/99 - Inspected drainfield -

1"=50'

INITIAL SITE SKETCH

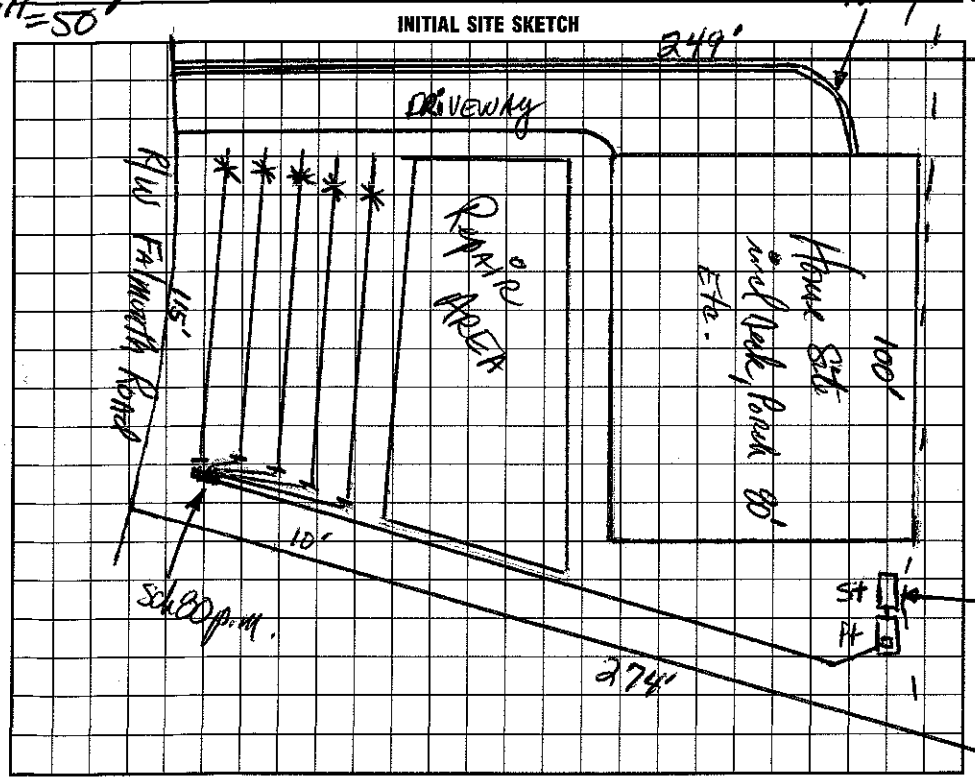

AS BUILT SKETCH

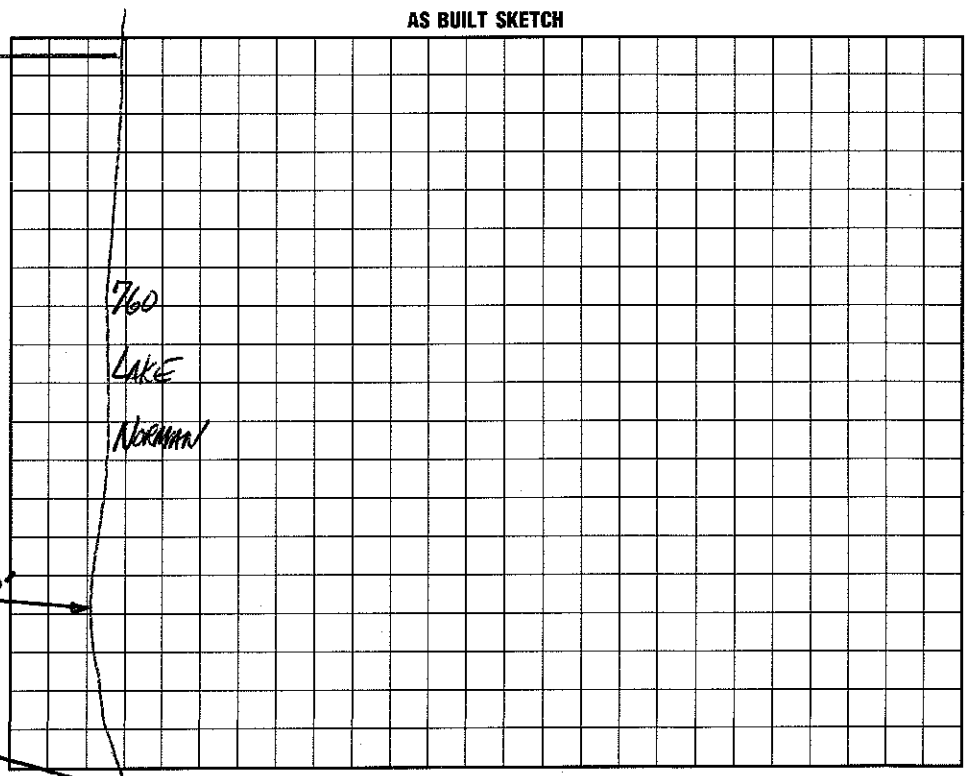

I understand that this permit can be suspended or revoked if any false information is supplied toward securing the permit/any unauthorized changes are made to the site/any unauthorized changes are made in the installation of the system. Improvement Permit with plat valid without expiration. Improvement Permit with site plan valid for sixty months. Authorization to Construct is valid for a period equal to that of Improvement Permit – not to exceed sixty months.

Signed: Patty Reny date 8-20-98 Installed by: Bob Mayhew

Improvement Permit by: Mark Johnson, RS date 8-10-98 Operation Permit by: Wesley Sparks R.S. date 1/21/00

Authorization to Construct by: Mark Johnson, RS date 2-16-99 Existing System Inspection by: date

HEALTH DEPT. COPY: WHITE INSPECTION COPY (FINAL): GREEN OWNER COPY (FINAL): YELLOW INSPECTION COPY (INITIAL): PINK OWNER COPY (INITIAL): GOLD