IREDELL COUNTY HEALTH DEPARTMENT

Statesville Phone TR 3-7271 Mooresville Phone NO 3-1271

PERMIT TO INSTALL SEPTIC TANK

Permit NO._____ Permit Date 4 Aug 1964.

Owner Mr. Coffee Address ——

Installed By Richard Armstrong Address Denver N.C.
Denver Plumbing Co


Location of Property Lot #21 Sarl Side Development.

| Tank | | Capacity | | Length of Lines | | Fixtures | |
|---|---|---|---|---|---|---|---|
| Block | ( ) | 800 | ( ) | 150' | ( ) | No. of Baths | ( ) |
| Precast | (X) | 900 | ( ) | 175' | ( ) | Dishwasher | ( ) |
| | | 1000 | (X) | 200' | ( ) | Garbage Grdr. | ( ) |
| | | 1100 | ( ) | 225' | (X) | Auto-Washer | ( ) |
| | | 1200 | ( ) | 250' | ( ) | Other | |
| | | Other | | Other | | | |

NOTIFY HEALTH DEPARTMENT AT LEAST EIGHT HOURS BEFORE TANK IS TO BE INSPECTED.

Final Inspection 4 Aug 1964 Approved (X) Disapproved ( )

Remarks

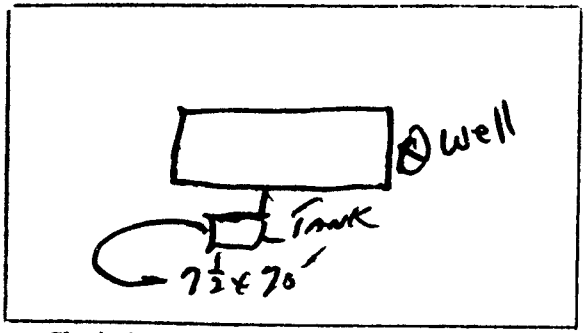


Sketch of Installation

Ray R. Scoggins
Sanitarian