IREDELL COUNTY HEALTH DEPARTMENT

Statesville Office (704) 878-5305 Mooresville Office (704) 660-3625 PERMIT # 1100 214105

IMPROVEMENT PERMIT / AUTHORIZATION TO CONSTRUCT / OPERATION PERMIT / EXISTING SYSTEM

PIN # 4635 28 3832

APPLICANT: Susan Jakubowski (SITE) APPLICANT ADDRESS: 150 Lake Pine Rd Mooresville, NC

SITE ADDRESS: Brawley School Rd, TL Isle of Pines T PHONE: ALT. PHONE:

SITE DIRECTIONS: Brawley School Rd TL Isle of Pines TR Waterford TL Lake Pine on right

SUBDIVISION: Pine Isle SECTION: 2 LOT # 60 LOT AREA: 1Ac DESIGN FLOW: 480gpd L.T.A.R.:

Septic Tank 1000 (gal) STB 1060 Date Plastic
Pump Tank 1000 (gal) PT Date
Pump Make Model Serial #
Nitrification Fields 1 # Lines 4 Linear Ft: 270'
Trench Width 24" Max. Trench Bottom Depth 28-36" Gravel Depth N/A

☐ New System ☒ Repair ☐ Expansion System Type: I II III (IV) V VI
System Description: ST-Only (LPPPBPS)
Repair System Description: LPPPBPS
Maintenance Agreement Required: ☒ YES ☐ NO ☐ GRAVITY ☒ PRESSURE


☒ Residence No. Bedrooms 4
☐ Business No. Persons 8
☐ Other No. Employees
☐ Slab ☒ Crawl Space
☐ Basement w/plumbing ☐ Basement w/o plumbing

Water Supply: ☐ Private ☐ Public ☒ Community

Comments / Conditions: 9

* Replace existing (damaged) Septictank (ST) with new ST, install as shown. Connect to exist Pumptank (PT) & Drainfield.

INITIAL SITE SKETCH

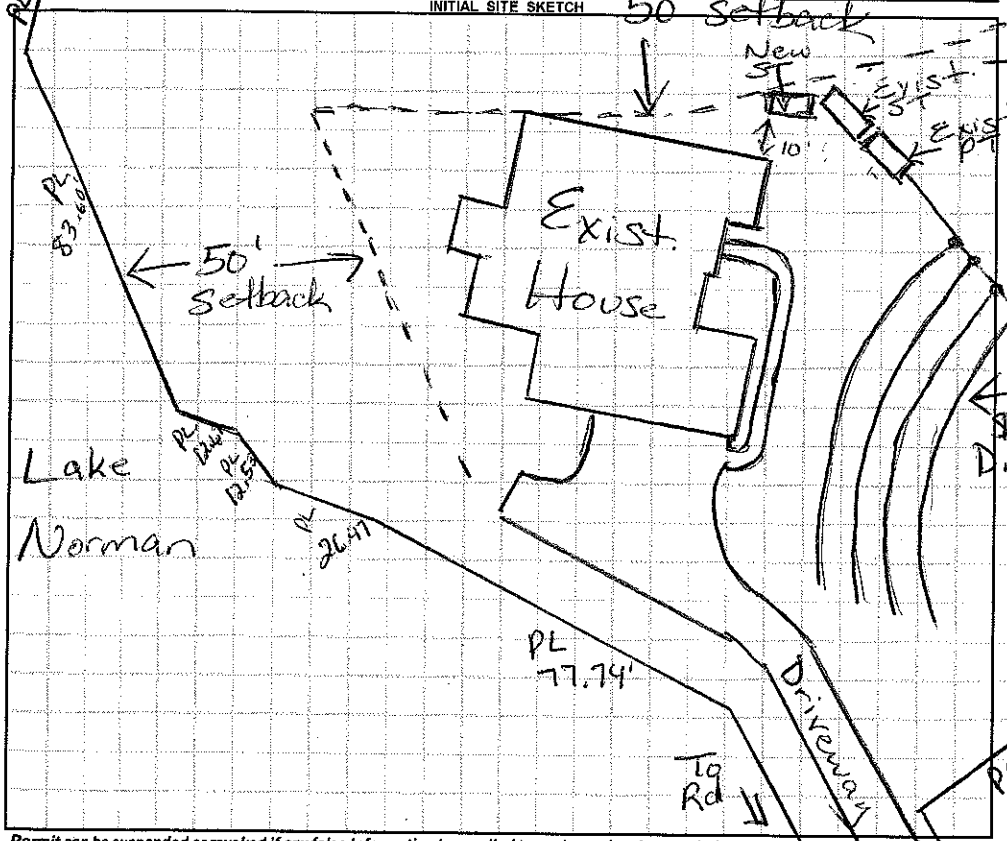

AS BUILT SKETCH

11/13/15 Scale 1:40 Exist ST

Permit can be suspended or revoked if any false information is supplied toward securing the permit / any unauthorized changes are made to the site / any unauthorized changes are made in the installation of the system. **CONTACT A LOCATOR SERVICE PRIOR TO ANY EXCAVATION**

☐ **IMPROVEMENT PERMIT** *with plat valid without expiration.* ☒ **IMPROVEMENT PERMIT** *with site plan valid for 60 mos.* ☒ **AUTHORIZATION TO CONSTRUCT** *valid for period equal to IMPROVEMENT PERMIT--not to exceed 60 mo.*

Owner / Applicant Signature: Date: 10/15/15 Installed by: Jarrid Lentz

IMPROVEMENT PERMIT by: Maria Dotson RS Date: 10/15/15 OPERATION PERMIT by: Maria Dotson RS Date: 11/17/15

AUTHORIZATION TO CONSTRUCT by: Maria Dotson RS Date: 10/15/15 Existing System Inspected by: Date:

Health Dept. Copy - WHITE Applicant (Final Approval) - YELLOW Applicant (Conditional Approval) - PINK