IREDELL COUNTY HEALTH DEPARTMENT

STATESVILLE 704-878-5305 MOORESVILLE 704-664-5281

4635 28 3832

IMPROVEMENT PERMIT / CERTIFICATE OF COMPLETION / OPERATION PERMIT / EXISTING SYSTEM INSPECTION

PROPERTY DESCRIPTION NO. 17109 DATE Oct. 25, 93 TAX MAP NO. 26 23A 63 Watershed: ☑ Yes ☐ No

OWNER OR CONTRACTOR M.I. Homes PHONE: Business 376-9800 Home L.M.

ADDRESS 1043 E. Morehead #105, Charlotte NC 28208

LOCATION 1160 TL 1113 TR Waterford TL Rockrimmon on Right

SUBDIVISION Pine Isle BLOCK / SECTION ____ LOT 60 LOT AREA 20,000 ft² SITE CLASS. PS on 1956 DESIGN FLOW 400/700 gpd L.T.A.R. .3

Septic Tank: 1000 Gallons; STB AW 782 Date 1-10-94

Pump Tank: 1000 Gallons; PT 103 Date 7-2-93

Pump Make: ____ Model ____ Serial No. ____

Nitrification Field: No Fields 1 Square Feet ____ Linear Feet 270

No Lines 4 Trench Width 24" Max Trench Bottom Depth 28"-36" Gravel Depth N/A

☑ New System ☐ Repair System Type: I, II, III, IV, V, VI

System Description: LP PPBPS

Repair System Description: LP PPBPS

Maintenance Agreement Required: ☑ Yes ☐ No

☑ House/Mod. Home No. Bedrooms 4

☐ Mobile Home No. Bathrooms 3½

☐ Business No. Employees ____

☐ Other ____

☐ Slab ☑ Crawl Space ☐ Basement w/plumbing ☐ Basement wo/plumbing


Water Supply: ☐ Individual ☑ Community ☐ Public

Comments:


No spacing / Cutting of soil around house site.

Comments:

INITIAL SITE SKETCH

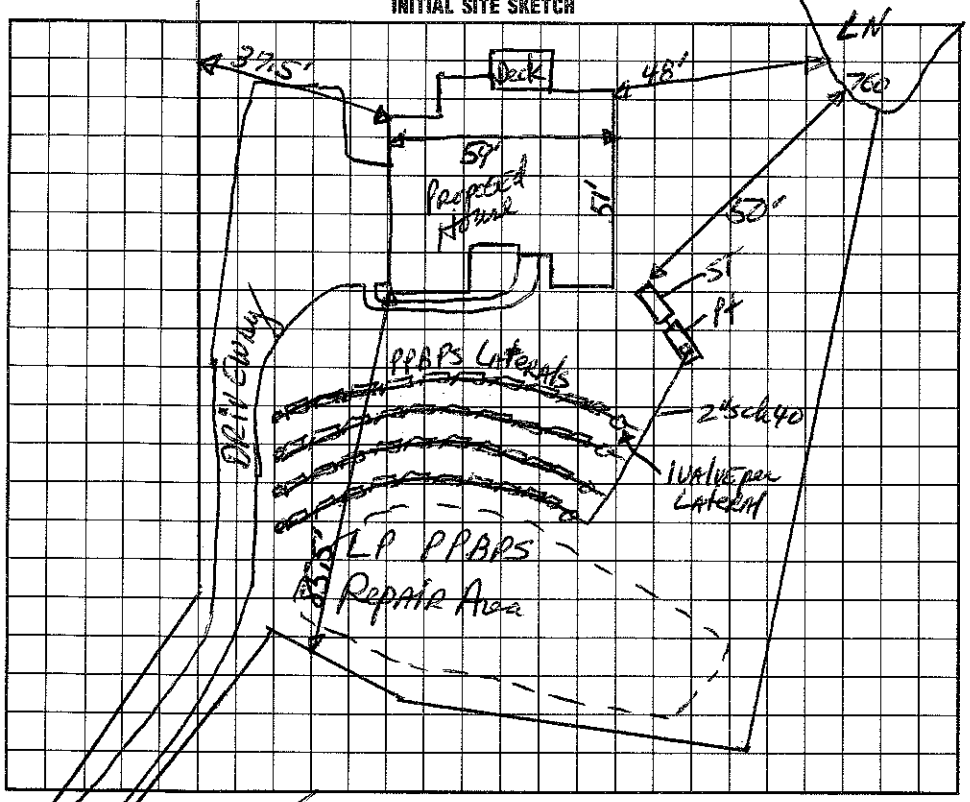

AS BUILT SKETCH

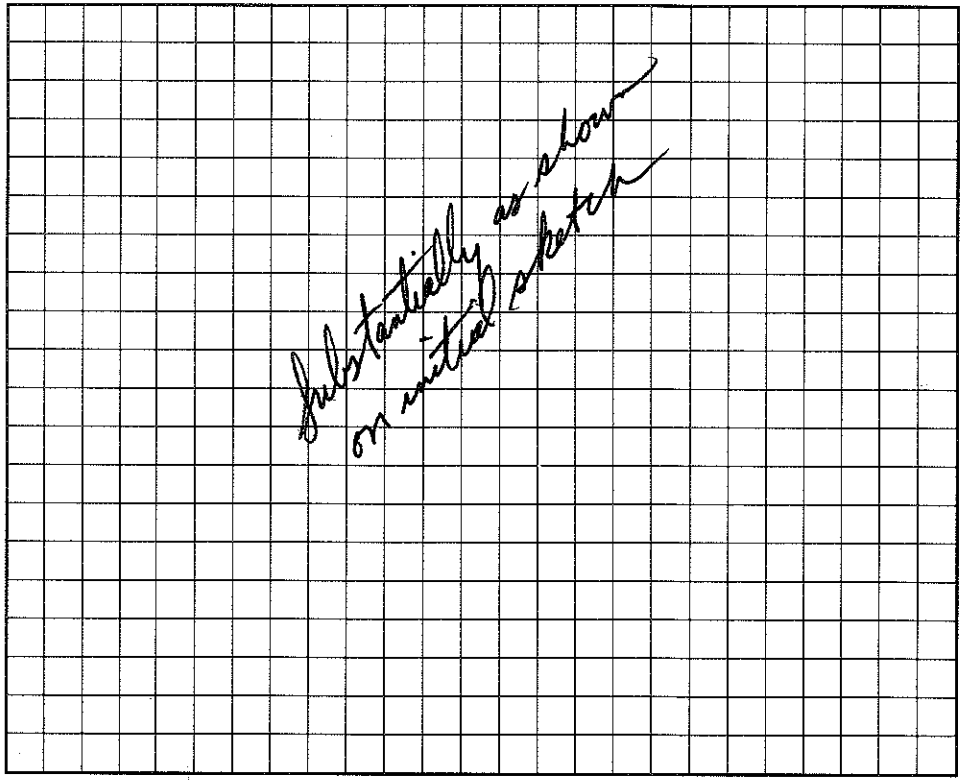

I understand that this permit can be suspended or revoked if any false information is supplied toward securing the permit/any unauthorized changes are made to the site/any unauthorized changes are made in the installation of the system. Improvement Permit is valid for 60 months from date of issuance.

Signed: X

Improvement Permit by: Jane R Hunter, RS date 10/25/93

Existing System Inspection by: ____ date ____

Installed by: Dobson

Certificate of Completion by: ____ date ____

Operation Permit by: Jane R Hunter, RS date 5/10/94

HEALTH DEPT. COPY: WHITE INSPECTION COPY (FINAL): GREEN OWNER COPY (FINAL): YELLOW INSPECTION COPY (INITIAL): PINK OWNER COPY (INITIAL): GOLD