IREDELL COUNTY HEALTH DEPARTMENT

STATESVILLE 704-878-5305 MOORESVILLE 704-664-5281

4635 28 4490

IMPROVEMENT PERMIT / CERTIFICATE OF COMPLETION / OPERATION PERMIT / EXISTING SYSTEM INSPECTION

PROPERTY DESCRIPTION NO. 16710 DATE August 6, '93 TAX MAP NO. 2623A64

OWNER OR CONTRACTOR MI Homes PHONE: Business Home

ADDRESS 1043 E. Morehead St, Charlotte NC 28204

LOCATION 110P TL 1113 TR Waterford TL Rockrimmon AT END

SUBDIVISION Pine Isle BLOCK / SECTION LOT 64 LOT AREA SITE CLASS 95 per 1956 L.T.A.R. .3

Water Supply: ☐ Individual ☑ Community ☐ Public

Septic Tank: 1000 Gallons; STB 358 Date 10-8-93

Pump Tank: 1000 Gallons; PT 103 Date 9-1-93

Nitrification Field: No Fields 1 Square Feet Linear Feet 270

No Lines 4 Trench Width 24" Trench Depth 30"-36" Gravel Depth NA

☑ New System ☐ Repair System Type: I, II, III, ⓘV, V, VI

System Description: LP Panel Block

Repair System Description: Same

Maintenance Agreement Required: ☑ Yes ☐ No

☑ House/Mod. Home No. Bedrooms 4 Garbage Disposal: ☐ Yes ☐ No

☐ Mobile Home No. Bathrooms 3½ Auto. Dishwasher: ☑ Yes ☐ No


☐ Business No. Employees Auto. Washing Machine: ☑ Yes ☐ No

☐ Other Other

☐ Slab ☑ Crawl Space ☐ Basement w/plumbing ☐ Basement wo/plumbing

Comments Septic Tank contractor note: KEEP trenches minimum spacing. Do not dodge trees, etc. Repair Area must be Reserved. ONE 3/16" hole per panel, 62 panels total, 2' pressure head. Pump Specs: 37gpm AT approx. 20' head

INITIAL SITE SKETCH

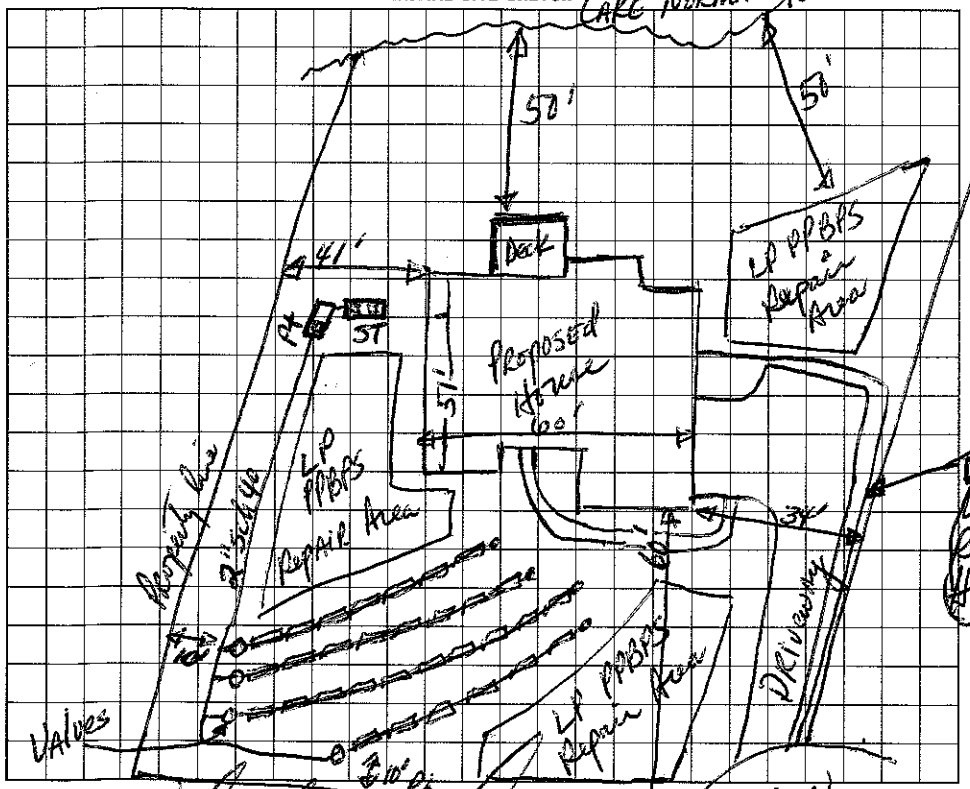

AS BUILT SKETCH

S/W 26 89 128

Goulds - WE05 11 HH

I understand that this permit can be suspended or revoked if any false information is supplied toward securing the permit/any unauthorized changes are made to the site/any unauthorized changes are made in the installation of the system. Improvement Permit is valid for 60 months from date of issuance.

Signed: X

Improvement Permit by: Janice R Hinson, RS date 8/6/93

Existing System Inspection by: date

Installed by:

Certificate of Completion by: date

Operation Permit by: Janice R Hinson RS date Jan 19, '94

HEALTH DEPT. COPY: WHITE INSPECTION COPY (FINAL): GREEN OWNER COPY (FINAL): YELLOW INSPECTION COPY (INITIAL): PINK OWNER COPY (INITIAL): GOLD