IREDELL COUNTY HEALTH DEPARTMENT

STATESVILLE 704-878-5305 (7")

4635 28 4529
MOORESVILLE 704-664-5281

IMPROVEMENT PERMIT / CERTIFICATE OF COMPLETION / OPERATION PERMIT / EXISTING SYSTEM INSPECTION

PROPERTY DESCRIPTION NO. 17245 DATE Nov. 30, '93 TAX MAP NO. 2623A62 Watershed: ☑ Yes ☐ No

OWNER OR CONTRACTOR M I Homes PHONE: Business 376-9800 Home

ADDRESS 1043 E. Morehead, Charlotte

LOCATION 1109 TR 1113 TR Watsford TL Rockmansville (Highway) at end on Right

SUBDIVISION Pine Hills BLOCK / SECTION LOT 62 LOT AREA 25,000 ft² SITE CLASS. 75 per 1936 DESIGN FLOW 480 gpd L.T.A.R. .3 gpd/ft²

Septic Tank: 1000 Gallons; STB 794 Date 4/11/94

Pump Tank: 1000 Gallons; PT 27 Date 4/14/94

Pump Make: Gould Model Serial No. 9IN2849039

Nitrification Field: No Fields 1 Square Feet Linear Feet 370

No Lines 4 Trench Width 24" Max Trench Bottom Depth 36" Gravel Depth N/A

☑ New System ☐ Repair System Type: I, II, III, (IV), V, VI

System Description: LPPBPS

Repair System Description: SAME

Maintenance Agreement Required: ☑ Yes ☐ No

☑ House/Mod. Home No. Bedrooms 4

☐ Mobile Home No. Bathrooms 4½

☐ Business No. Employees

☐ Other


☐ Slab ☐ Crawl Space ☑ Basement w/plumbing ☐ Basement wo/plumbing

Water Supply: ☐ Individual ☑ Community ☐ Public

Comments: Laterals to follow contour. Supply line (2" sch 40) must be 10' off basement wall and 10' off property line. 62 panels total; one 3/16" hole per panel. Pump specs: 37 gal/min at Approx 30' head

Comments:
DRAIN FIELD OK ALREM OK
PIT OK
SIT OK 6/1/94 AWS

INITIAL SITE SKETCH

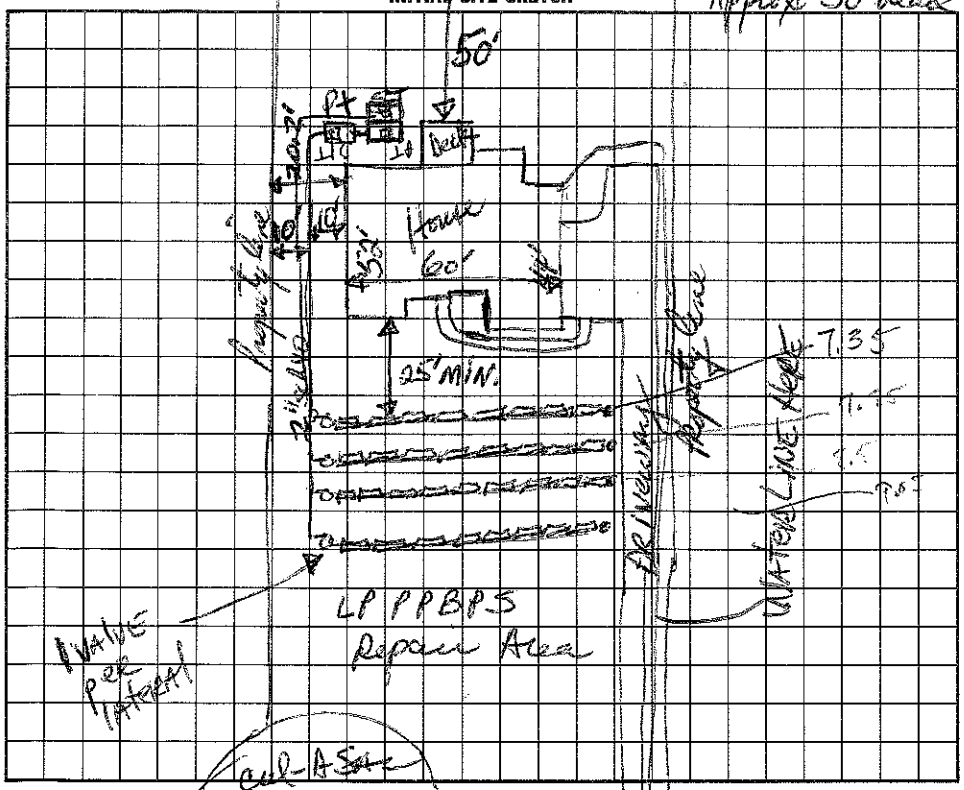

AS BUILT SKETCH

I understand that this permit can be suspended or revoked if any false information is supplied toward securing the permit/any unauthorized changes are made to the site/any unauthorized changes are made in the installation of the system. Improvement Permit is valid for 60 months from date of issuance.

Signed Rockmansville

Improvement Permit by: Jarrell R Hunsucker, RS date 11/30/93

Existing System Inspection by: date

Installed by: D Brown

Certificate of Completion by: date

Operation Permit by: Jarrell R Hunsucker, RS date 6/23/94

HEALTH DEPT. COPY: WHITE INSPECTION COPY (FINAL): GREEN OWNER COPY (FINAL): YELLOW INSPECTION COPY (INITIAL): PINK OWNER COPY (INITIAL): GOLD