IREDELL COUNTY HEALTH DEPARTMENT

STATESVILLE 704-878-5305 — MOORESVILLE 704-664-5281

4635 28 4679

IMPROVEMENT PERMIT / CERTIFICATE OF COMPLETION / OPERATION PERMIT / EXISTING SYSTEM INSPECTION

PROPERTY DESCRIPTION NO. 17017 DATE October 6, '93 TAX MAP NO. 2623A61

OWNER OR CONTRACTOR M.T. Homes PHONE: Business 376-9800 Home

ADDRESS 1043 E. Morehead Suite 105, Charlotte 28204

LOCATION 160 TL 113 TR Waterford TL Rocksimmon on Right

SUBDIVISION Pine Isle BLOCK / SECTION LOT 61 LOT AREA ~3/4 Ac SITE CLASS. PS L.T.A.R. .3

Water Supply: ☐ Individual ☑ Community ☐ Public Gould's WE05 11HH

Septic Tank: 1000 Gallons; STB 358 ACP Date 12-7-93 SN2754026

Pump Tank: 1000 Gallons; PT 103 ACP Date 8-24-93

Nitrification Field: No Fields 1 Square Feet Linear Feet 270

No Lines 4 Trench Width 24" Trench Depth 28"-36" Gravel Depth NA

☑ New System ☐ Repair System Type: I, II, II, ⓘ V, VI

System Description: LP PRBPS

Repair System Description: SAME

Maintenance Agreement Required: ☑ Yes ☐ No

☑ House/Mod. Home No. Bedrooms 4

☐ Mobile Home No. Bathrooms 2½

☐ Business No. Employees

☐ Other

☐ Slab ☑ Crawl Space ☐ Basement w/plumbing ☐ Basement wo/plumbing

Garbage Disposal: ☑ Yes ☐ No

Auto. Dishwasher: ☑ Yes ☐ No


Auto. Washing Machine: ☑ Yes ☐ No

Other

Comments 60 panels total; ONE 3/16" hole per panel; 2' pressure head. Laterals to follow contour. Pump specs: 3½ gal per minute at Approx. 25' head.

Maintenance agreement rec'd 3/29/94 DHH

INITIAL SITE SKETCH

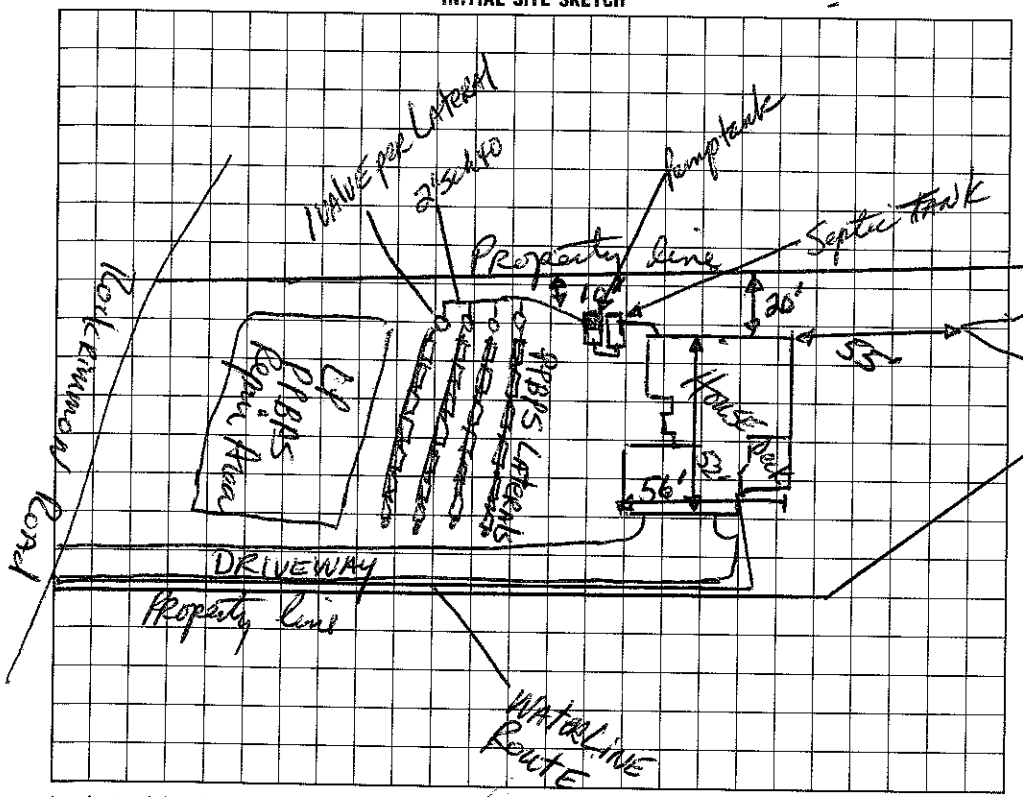

AS BUILT SKETCH

I understand that this permit can be suspended or revoked if any false information is supplied toward securing the permit/any unauthorized changes are made to the site/any unauthorized changes are made in the installation of the system. Improvement Permit is valid for 60 months from date of issuance.

Signed:

Improvement Permit by: date 10/6/93

Existing System Inspection by: date

Installed by:

Certificate of Completion by: date

Operation Permit by: date 3/29/94

HEALTH DEPT. COPY: WHITE — INSPECTION COPY (FINAL): GREEN — OWNER COPY (FINAL): YELLOW — INSPECTION COPY (INITIAL): PINK — OWNER COPY (INITIAL): GOLD