IREDELL COUNTY HEALTH DEPARTMENT

STATESVILLE 704-878-5305 MOORESVILLE 704-664-5281

IMPROVEMENT PERMIT / AUTHORIZATION TO CONSTRUCT / OPERATION PERMIT / EXISTING SYSTEM INSPECTION

PERMIT# Repair PIN# ~~4635 27 6915~~ 4635 28 5073 DATE 3/9/05

OWNER OR CONTRACTOR Steve Davis PHONE: Business Home 704-576-2898

ADDRESS 130 Ski Haven Dr. Mooresville, NC. 28117

LOCATION 1100 TL Isle of Pines TR Ski Haven Dr. to 130 on cul de sac

SUBDIVISION Sunside Estates BLOCK / SECTION LOT ~~2~~ 4 LOT AREA EXISTING SITE CLASS. RS DESIGN FLOW 360 L.T.A.R. .3

Septic Tank: 1000 Gallons; STB 794 Date 6-21-04

Pump Tank: Gallons; PT Date

Pump Make: Model Serial No.

Nitrification Field: No Fields 1 Square Feet 600 Linear Feet 200

No Lines 4@50' Trench Width 3' Max Trench Bottom Depth 3'

☒ New System ☐ Repair System Type: I, II, III, IV, V, VI

System Description: GRAVITY - 16" PPBRS

Repair System Description: 16" PPBRS

Maintenance Agreement Required: ☐ Yes ☒ No

☒ House/Mod. Home No. Bedrooms 3

☐ Mobile Home No. Bathrooms 2

☐ Business No. Employees

☐ Other


Water Supply: ☒ Individual ☐ Public ☐ Community

Gravel Depth NA ☐ Slab ☒ Crawl Space ☐ Basement w/plumbing ☐ Basement wo/plumbing

Comments:/Conditions:

Comments:/Conditions:

INITIAL SITE SKETCH

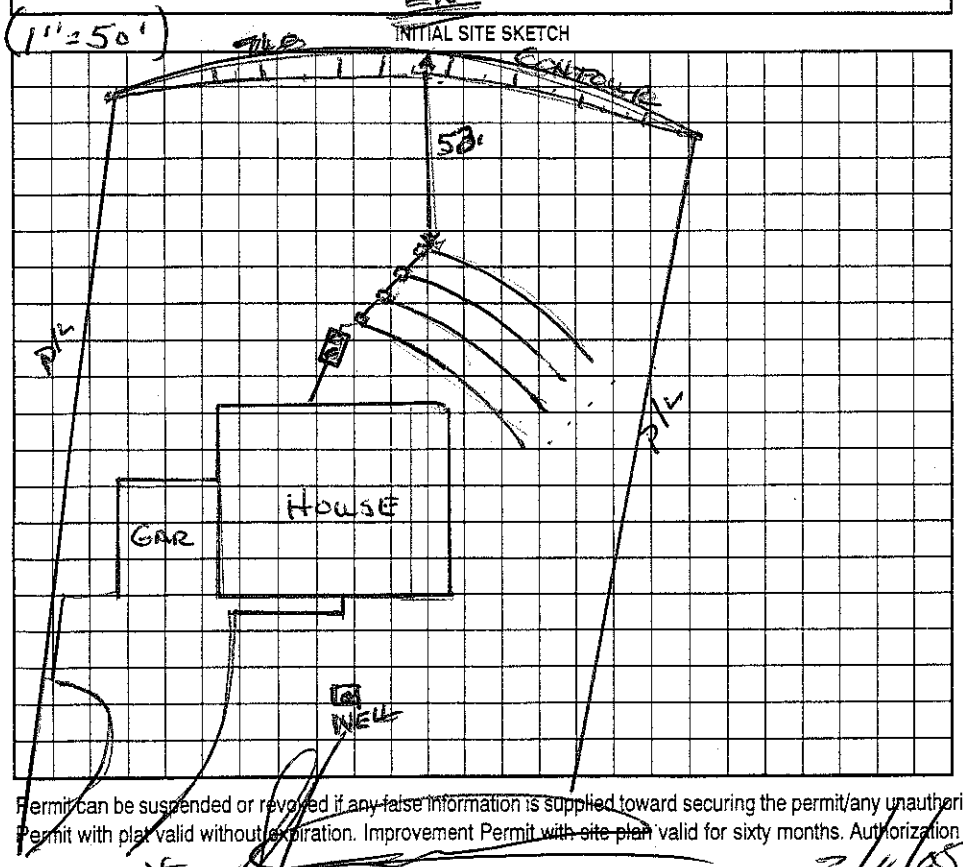

AS BUILT SKETCH

Permit can be suspended or revoked if any false information is supplied toward securing the permit/any unauthorized changes are made to the site/any unauthorized changes are made in the installation of the system. Improvement Permit with plat valid without expiration. Improvement Permit ~~with site plan~~ valid for sixty months. Authorization to Construct is valid for a period equal to that of Improvement Permit – not to exceed sixty months.

Signed: X date 3/11/05

Improvement Permit by: Wesley Sparks RS. date 3/9/05

Authorization to Construct by: Wesley Sparks RS. date 3/9/05

Installed by: Stanley Septic Tank

Operation Permit by: Wesley Sparks RS. date 5/4/05

Existing System Inspection by: date

HEALTH DEPT. COPY: WHITE OWNER COPY (FINAL): YELLOW OWNER COPY (INITIAL): PINK