IREDELL COUNTY HEALTH DEPARTMENT

STATESVILLE 704-878-5305 MOORESVILLE 704-664-5281

4635 28 6209

IMPROVEMENT PERMIT / CERTIFICATE OF COMPLETION / OPERATION PERMIT / EXISTING SYSTEM INSPECTION

PROPERTY DESCRIPTION NO. 17018 DATE Sept 24, '93 TAX MAP NO. 2623A65

OWNER OR CONTRACTOR MI Homes PHONE: Business 376-9800 Home

ADDRESS 1043 E. Morehead Charlotte

LOCATION 1100 ft Waterford TL Rockingham (Highview) at End

SUBDIVISION Pine Isle BLOCK / SECTION II LOT 65 LOT AREA ~ 3/4 AC SITE CLASS. RS per 1956 L.T.A.R. .3

Water Supply: ☐ Individual ☑ Community ☐ Public

Septic Tank: 1000 Gallons; STB 358 ACP Date 11-21-93

Pump Tank: 1000 Gallons; PT 163 ACP Date 11-1-93

Nitrification Field: No. Fields 1 Square Feet ____ Linear Feet 270

No. Lines 4 Trench Width 24" Trench Depth 28-30" Gravel Depth NA

☑ New System ☐ Repair System Type: I, II, II, (IV), V, VI

System Description: LP PPBPS

Repair System Description: Same

Maintenance Agreement Required: ☑ Yes ☐ No

☑ House/Mod. Home ☐ Mobile Home ☐ Business ☐ Other

No. Bedrooms 4 No. Bathrooms 3 No. Employees ____

☐ Slab ☑ Crawl Space ☐ Basement w/plumbing ☐ Basement wo/plumbing

Garbage Disposal: ☑ Yes ☐ No


Auto. Dishwasher: ☑ Yes ☐ No

Auto. Washing Machine: ☑ Yes ☐ No

Other ____

Comments 62 panels total, one 3/16" hole per panel, 2' pressure head. Pump specs: 37 gal/min @ approx. 25' head.

INITIAL SITE SKETCH

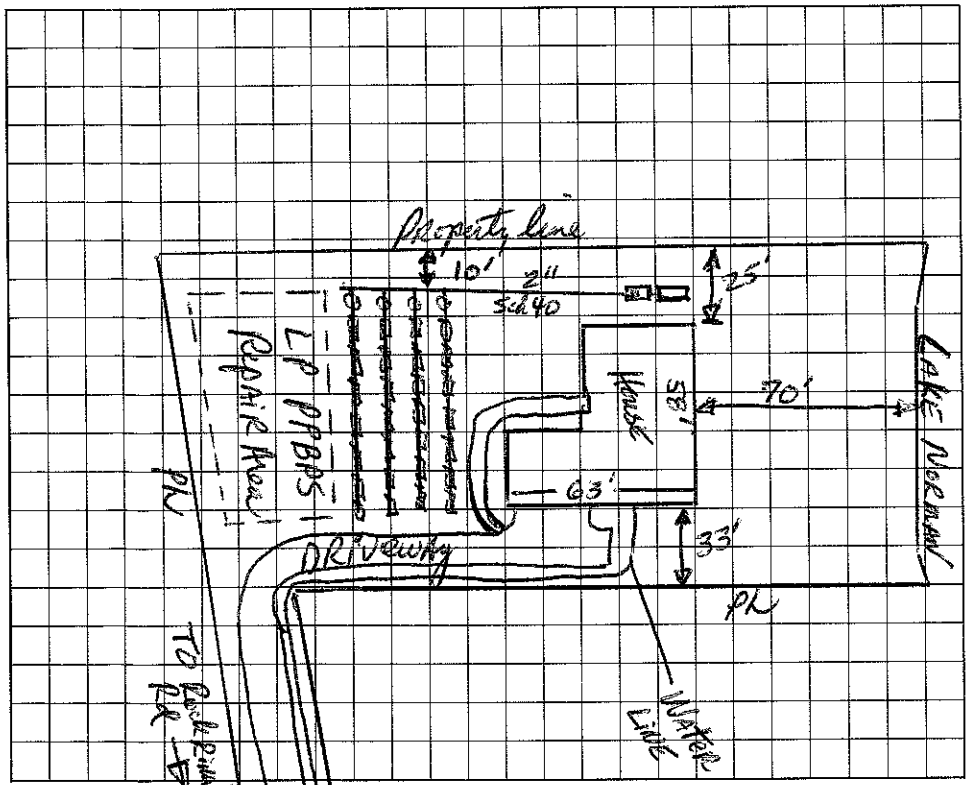

AS BUILT SKETCH

Essentially as shown on initial sketch

I understand that this permit can be suspended or revoked if any false information is supplied toward securing the permit/any unauthorized changes are made to the site/any unauthorized changes are made in the installation of the system. Improvement Permit is valid for 60 months from date of issuance.

Signed: ____

Improvement Permit by: David R. Hanson, RS date 9/24/93

Existing System Inspection by: ____ date ____

Installed by: ____

Certificate of Completion by: ____ date ____

Operation Permit by: David R. Hanson, RS date 2-2-94

HEALTH DEPT. COPY: WHITE INSPECTION COPY (FINAL): GREEN OWNER COPY (FINAL): YELLOW INSPECTION COPY (INITIAL): PINK OWNER COPY (INITIAL): GOLD