# IREDELL COUNTY HEALTH DEPARTMENT

STATESVILLE 704-878-5305 MOORESVILLE 704-664-5281

## IMPROVEMENT PERMIT / CERTIFICATE OF COMPLETION / OPERATION PERMIT / EXISTING SYSTEM INSPECTION

PROPERTY DESCRIPTION NO. 17019 DATE Sept 20, '93 TAX MAP NO. 2623A66

OWNER OR CONTRACTOR M.I. Homes PHONE: Business 376-9800 Home

ADDRESS 1043 E. Morehead Charlotte

LOCATION 1100 TL, 1113 TR Waterford TL Highview (Rockrimmon) near end on left 4635-28-6469

SUBDIVISION Pine Isle BLOCK / SECTION LOT 66 LOT AREA 1 Acre SITE CLASS. Bper 1956 L.T.A.R. .3 gal/ft²/day

Water Supply: ☐ Individual ☑ Community ☐ Public

Septic Tank: 1000 Gallons; STB 358 ACP Date 10-26-93

Pump Tank: Gallons; PT Date

Nitrification Field: No. Fields 1 Square Feet Linear Feet 270

No Lines 5 Trench Width 24" Trench Depth 28" Gravel Depth NA

☑ New System ☐ Repair System Type: I, II, III, IV, V, VI

System Description: gravity PPBPS

Repair System Description: Ejector LP PPBPS

Maintenance Agreement Required: ☐ Yes ☑ No

☑ House/Mod. Home No. Bedrooms 4

☐ Mobile Home No. Bathrooms 2½

☐ Business No. Employees

☐ Other

☐ Slab ☑ Crawl Space ☐ Basement w/plumbing ☐ Basement wo/plumbing

Garbage Disposal: ☑ Yes ☐ No


Auto. Dishwasher: ☑ Yes ☐ No

Auto. Washing Machine: ☑ Yes ☐ No

Other

Comments Install trenches on contour.

**INITIAL SITE SKETCH**

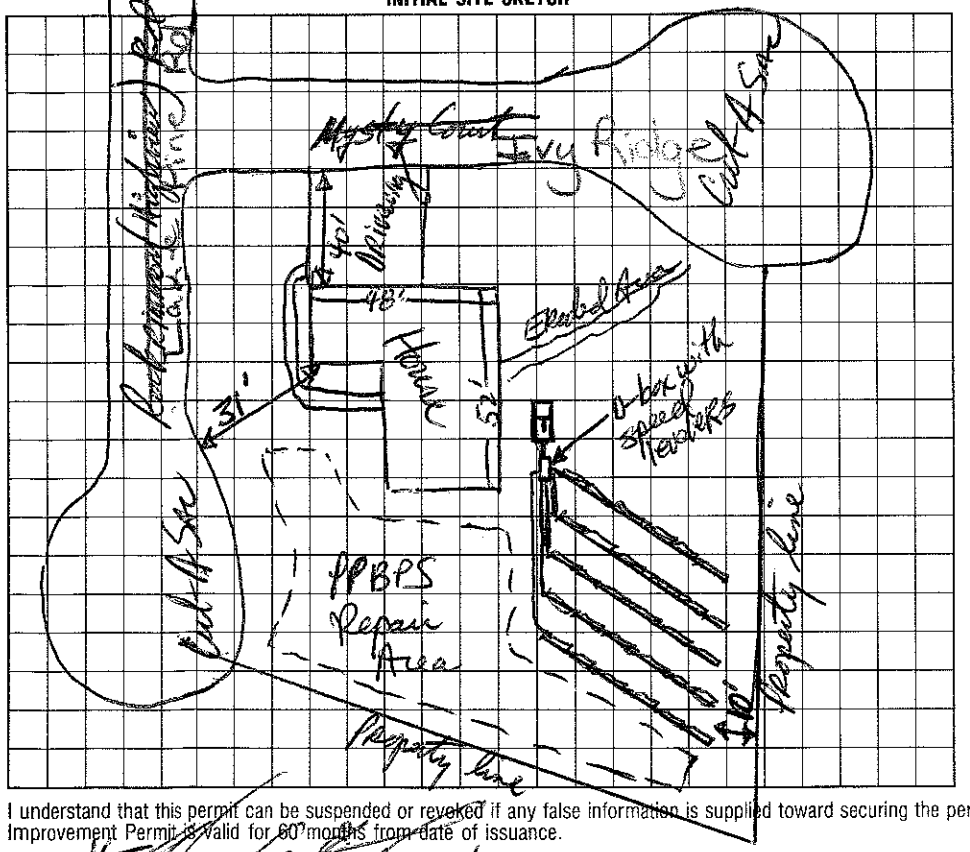


**AS BUILT SKETCH**

As shown on initial sketch

I understand that this permit can be suspended or revoked if any false information is supplied toward securing the permit/any unauthorized changes are made to the site/any unauthorized changes are made in the installation of the system. Improvement Permit is valid for 60 months from date of issuance.

Signed:

Improvement Permit by: David R. Hinson, RS date Sept 20, '93

Existing System Inspection by: date

Installed by: Dobson

Certificate of Completion by: date

Operation Permit by: David R. Hinson, RS date 12/2/93

HEALTH DEPT. COPY: WHITE INSPECTION COPY (FINAL): GREEN OWNER COPY (FINAL): YELLOW INSPECTION COPY (INITIAL): PINK OWNER COPY (INITIAL): GOLD