4635-28-7627

IREDELL COUNTY HEALTH DEPARTMENT

STATESVILLE 704-878-5305 MOORESVILLE 704-664-5281

IMPROVEMENT PERMIT / CERTIFICATE OF COMPLETION / OPERATION PERMIT / EXISTING SYSTEM INSPECTION

PROPERTY DESCRIPTION NO. 1744 DATE October 14, 1993 TAX MAP NO. 3623A 71

OWNER OR CONTRACTOR M I Homes PHONE: Business 376-9800 Home

ADDRESS 1043 E. Wakefield Charlotte

LOCATION 1100' ± of 113 TR Waterford TR, Rockrimmon (Highview) on left Corner w/ Ingridge (privately)

SUBDIVISION Pine Isle BLOCK / SECTION 2 LOT 71 LOT AREA ≥ 20,000 ± ft² SITE CLASS. B L.T.A.R. 3 gal/ft²/day

Water Supply: ☐ Individual ☑ Community ☐ Public

Septic Tank: 1000 Gallons; STB 358 ACP Date 11-10-93

Pump Tank: _____ Gallons; PT _____ Date _____

Nitrification Field: No. Fields 1 Square Feet 1200 Linear Feet 400

No Lines 5 Trench Width 36" Trench Depth 24" Gravel Depth 12"

☑ New System ☐ Repair System Type: I, II, III, IV, V, VI

System Description: gravity conventional

Repair System Description: pumped conventional

Maintenance Agreement Required: ☐ Yes ☐ No

☑ House/Mod. Home No. Bedrooms 3 Garbage Disposal: ☑ Yes ☐ No

☐ Mobile Home No. Bathrooms 2½ Auto. Dishwasher: ☑ Yes ☐ No


☐ Business No. Employees _____ Auto. Washing Machine: ☑ Yes ☐ No

☐ Other _____ Other _____


☐ Slab ☑ Crawl Space ☐ Basement w/plumbing ☐ Basement wo/plumbing

Comments Follow contour with notification to Gabriels.

INITIAL SITE SKETCH

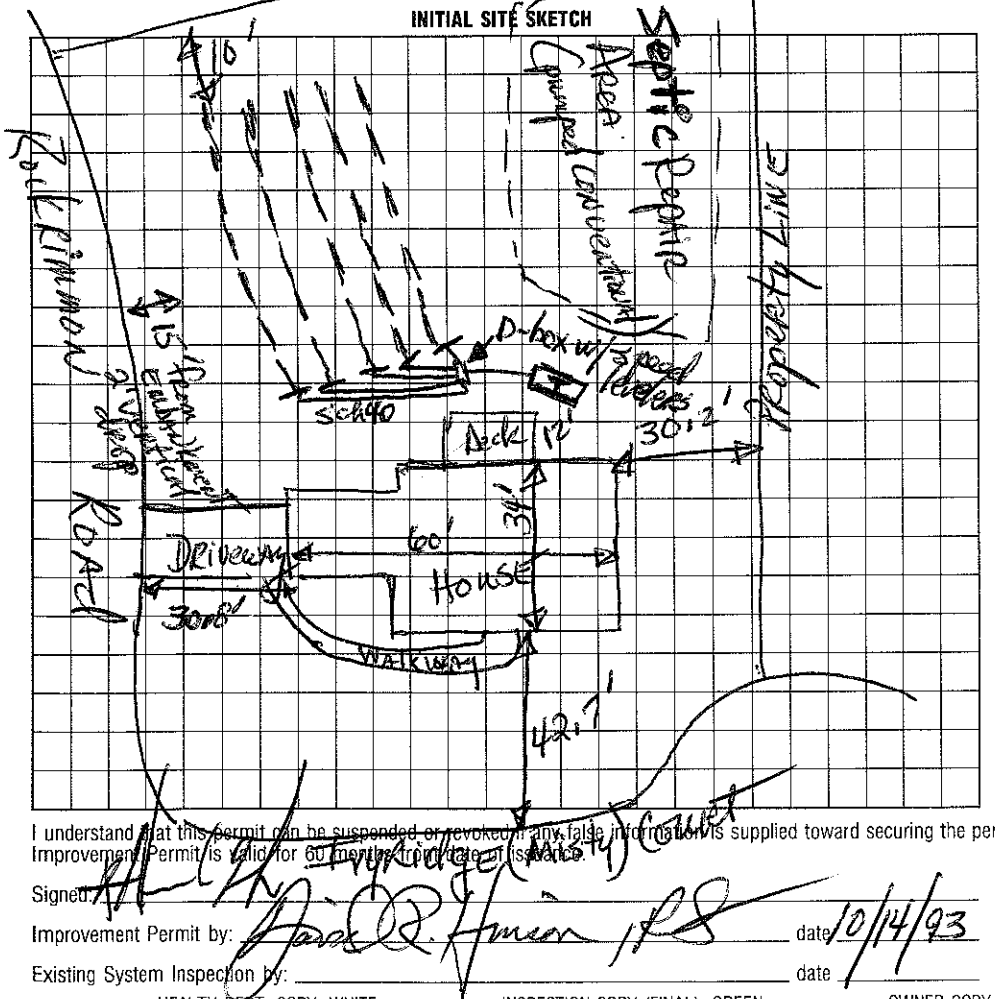

AS BUILT SKETCH

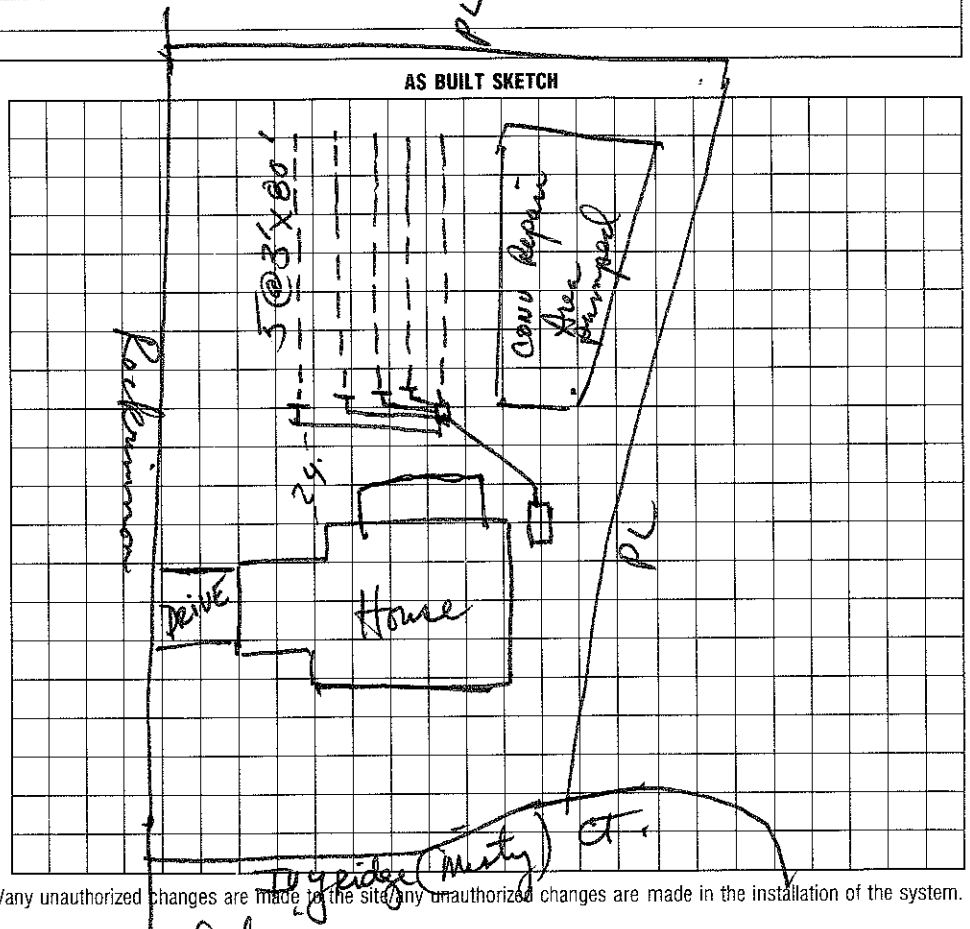

I understand that this permit can be suspended or revoked if any false information is supplied toward securing the permit/any unauthorized changes are made to the site/any unauthorized changes are made in the installation of the system. Improvement Permit is valid for 60 months from date of issuance.

Signed: _____

Improvement Permit by: Jack R. Hinson, RS date 10/14/93

Existing System Inspection by: _____ date _____

Installed by: Osborn

Certificate of Completion by: DR Hinson, RS date Jan 6/94

Operation Permit by: _____ date _____

HEALTH DEPT. COPY: WHITE INSPECTION COPY (FINAL): GREEN OWNER COPY (FINAL): YELLOW INSPECTION COPY (INITIAL): PINK OWNER COPY (INITIAL): GOLD