# IREDELL COUNTY HEALTH DEPARTMENT

STATESVILLE 704-878-5305 MOORESVILLE 704-664-5281

## IMPROVEMENT PERMIT / CERTIFICATE OF COMPLETION / OPERATION PERMIT / EXISTING SYSTEM INSPECTION

PROPERTY DESCRIPTION NO. 17244 DATE October 14, 1993 TAX MAP NO. 3623A 71

OWNER OR CONTRACTOR MI Homes PHONE: Business 376-9800 Home

ADDRESS 1093 E. Mallard Charlotte

LOCATION 1100 ft of 1113 ft Waterford Dr, ft Rockingham (Highview) on left Corner w/ Ingridge (Misty)

SUBDIVISION Pine Isle BLOCK / SECTION 2 LOT 71 LOT AREA ≥ 20,000 ft² SITE CLASS. 45 L.T.A.R. .3 gal/ft²/day

Water Supply: ☐ Individual ☑ Community ☐ Public

Septic Tank: 1000 Gallons; STB 358 ACP Date 11-10-93

Pump Tank: ____ Gallons; PT ____ Date ____

Nitrification Field: No. Fields 1 Square Feet 1200 Linear Feet 400

No. Lines 5 Trench Width 36" Trench Depth 24" Gravel Depth 12"

☑ New System ☐ Repair System Type: I, (II), III, IV, V, VI

System Description: gravity conventional

Repair System Description: pumped conventional

Maintenance Agreement Required: ☐ Yes ☐ No

☑ House/Mod. Home ☐ Mobile Home ☐ Business ☐ Other

No. Bedrooms 3 No. Bathrooms 2½ No. Employees ____

☐ Slab ☑ Crawl Space ☐ Basement w/plumbing ☐ Basement wo/plumbing

Garbage Disposal: ☑ Yes ☐ No


Auto. Dishwasher: ☑ Yes ☐ No

Auto. Washing Machine: ☑ Yes ☐ No


Other ____

Comments Follow contour with nitrification lateals.

INITIAL SITE SKETCH

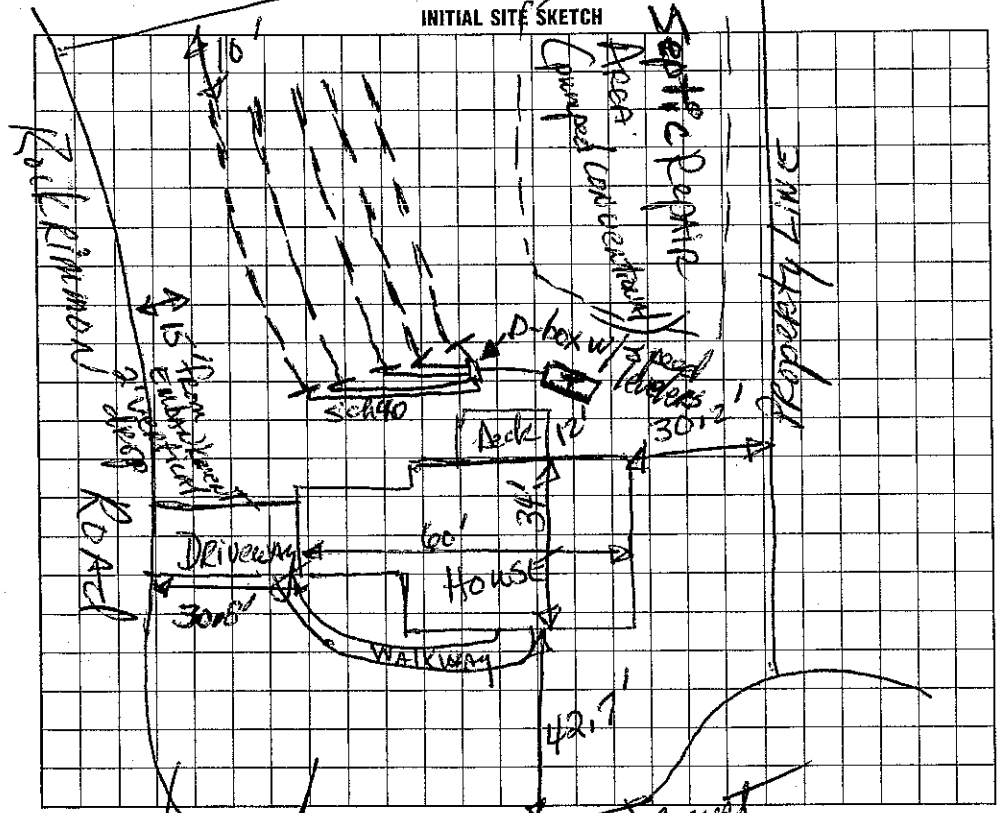


AS BUILT SKETCH

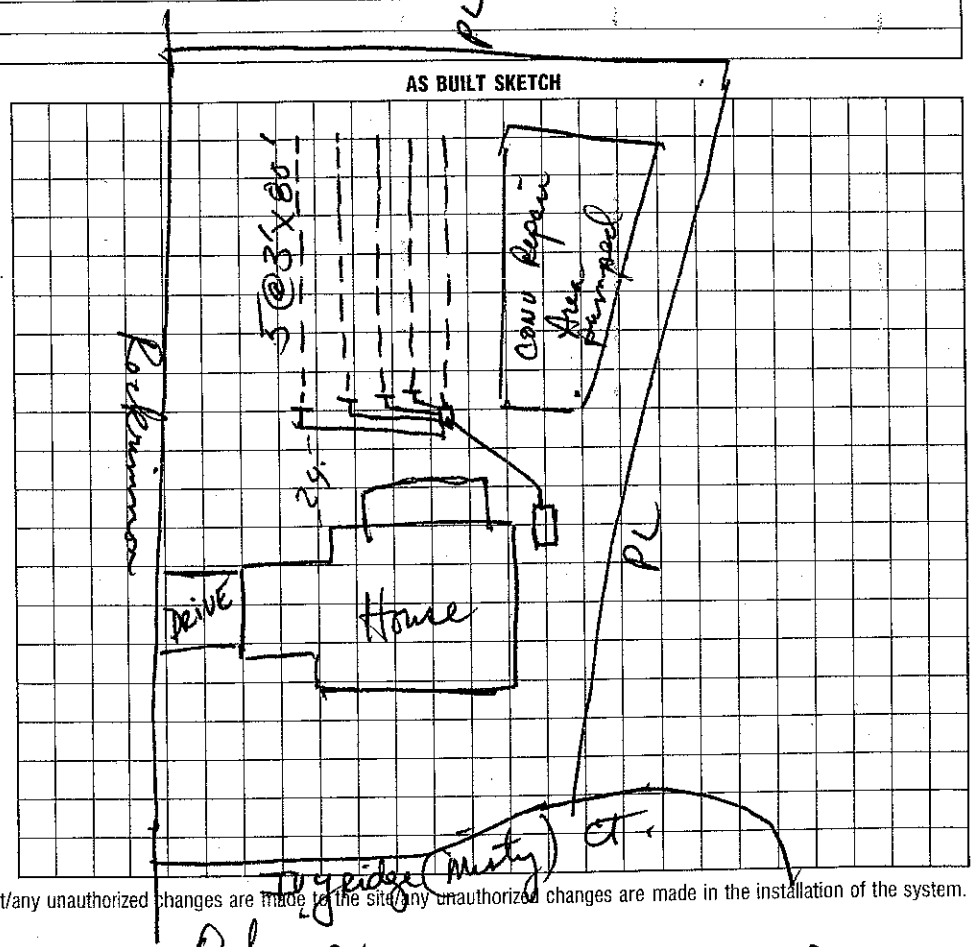


I understand that this permit can be suspended or revoked if any false information is supplied toward securing the permit/any unauthorized changes are made to the site/any unauthorized changes are made in the installation of the system. Improvement Permit is valid for 60 months from date of issuance.

Signed: ____

Improvement Permit by: Mark R. Hinson, RS date 10/14/93

Existing System Inspection by: ____ date ____

Installed by: Osborne

Certificate of Completion by: DR Hinson, RS date Jan 6/94

Operation Permit by: ____ date ____

HEALTH DEPT. COPY: WHITE INSPECTION COPY (FINAL): GREEN OWNER COPY (FINAL): YELLOW INSPECTION COPY (INITIAL): PINK OWNER COPY (INITIAL): GOLD