IREDELL COUNTY HEALTH DEPARTMENT

STATESVILLE 704-878-5305 MOORESVILLE 704-664-5281

IMPROVEMENT PERMIT / AUTHORIZATION TO CONSTRUCT / OPERATION PERMIT / EXISTING SYSTEM INSPECTION

PERMIT # 160267 PIN # 4635288656 DATE 3-8-2010

OWNER or APPLICANT Timothy Thomas PHONE: Business 704 799-3675 Home: 704 663-5640

OWNER or APPLICANT ADDRESS 103 Ivy Ridge Ct. Mooresville, NC 28117

LOCATION / DIRECTIONS Brawley School Rd TL Isle of Pines TR Waterford TL Lake Pine TL Ivy Ridge on left

SUBDIVISION Pine Isle. BLOCK / SECTION LOT # 70 LOT AREA .744Ac. DESIGN FLOW 480gpd T.A.R. .3

Septic Tank 1000 Gallons: STB Date

Pump Tank 1000 Gallons: P T Date

Pump Make Model Serial #

Nitrification Field No Fields 1 No Lines 4 Linear Feet 270'

Trench Width 24" Max. Trench Bottom Depth 36" Gravel Depth N/A

☐ New System ☐ Repair ☐ Expansion System Type I II III IV V VI

System Description: Exist. Pump-LP-Panel Blk

Repair System Description: Same

Maintenance Agreement Required ☒ YES ☐ NO

☐ GRAVITY ☒ PRESSURE


☒ Residence No. Bedrooms 4 ☐ Business No. Persons ☐ Other No. Employees ☐ Slab ☐ Crawl Space ☐ Basement w/plumbing ☐ Basement w/o plumbing

Water Supply: ☐ Private ☒ Public ☒ Community


Comments / Conditions: Existing Septic System appears to be functioning okay at time of Inspection. Scale 1:50

Comments / Conditions: Addition of Shop Should not impact Existing Septic System. Per Tri County last inspection done 9/23/2010

INITIAL SITE SKETCH

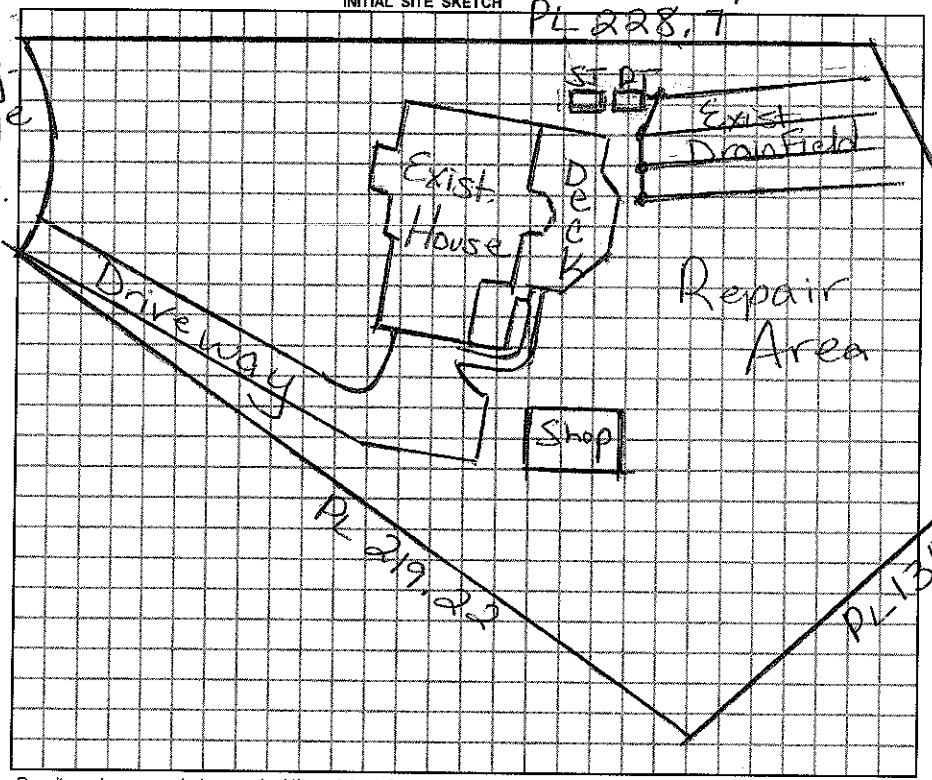

AS BUILT SKETCH

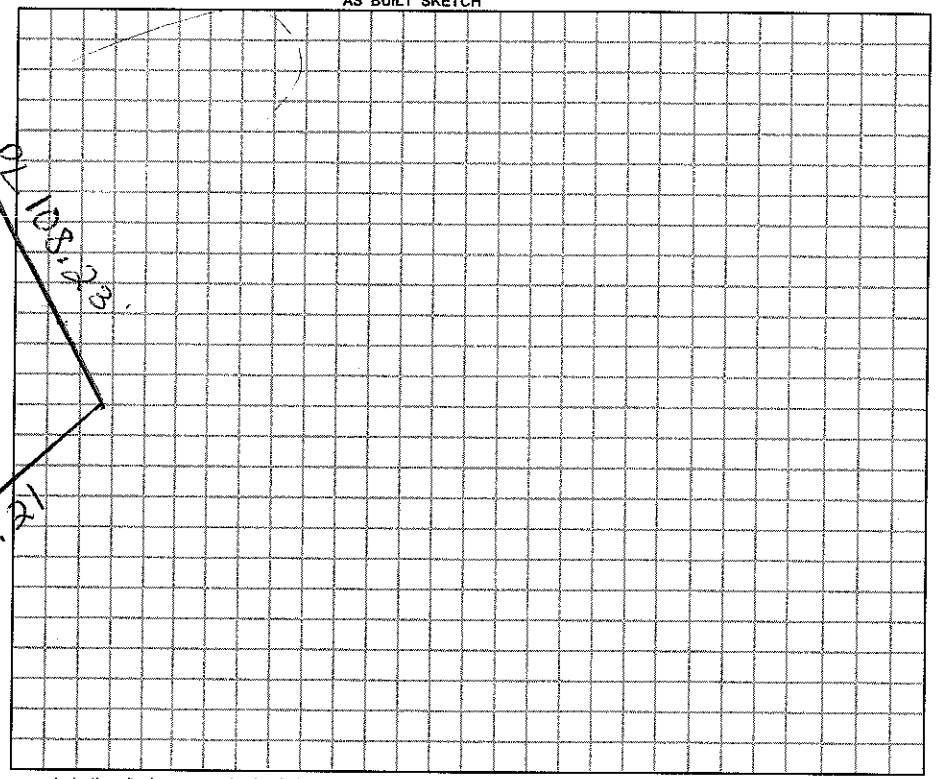

Permit can be suspended or revoked if any false information is supplied toward securing the permit / any unauthorized changes are made to the site / any unauthorized changes are made in the installation of the system.

☐ *IMPROVEMENT PERMIT w / plat valid without expiration.* ☐ *IMPROVEMENT PERMIT w / site plan valid for 60 mos.* ☐ *AUTHORIZATION TO CONSTRUCT valid for period equal to IMPROVEMENT PERMIT-not to exceed 60 mo.*

Owner / Applicant Signature: Cynthia Vin Thomas Date 3-8-2010

Improvement Permit by: Date

Authorzation to Construct by: Date

YOU SHOULD CONTACT A LOCATOR SERVICE PRIOR TO ANY EXCAVATION.

Installed by:

Operation Permit by: Date:

Existing System Inspected by: Marina Hill Dotson RS Date: 3/8/2010

WHITE COPY Environmental Health YELLOW COPY (Final) Owner / Applicant PINK COPY (Initial) Owner / Applicant