IREDELL COUNTY HEALTH DEPARTMENT

STATESVILLE 704-878-5305 MOORESVILLE 704-664-5281

4635 28 8656

IMPROVEMENT PERMIT / CERTIFICATE OF COMPLETION / OPERATION PERMIT / EXISTING SYSTEM INSPECTION

PROPERTY DESCRIPTION NO. 19016 DATE June 14, 194 TAX MAP NO. 2623B70 Watershed: ☑ Yes ☐ No

OWNER OR CONTRACTOR MI Homes PHONE: Business _____ Home _____ LN

ADDRESS 1043 E. Morehead, Charlotte

LOCATION 400 ft 4113 ft R Waterford TL Lake Pine TL Ivy Ridge on left in cul-de-sac

SUBDIVISION Pine Isle BLOCK / SECTION LOT 70 LOT AREA 32,407 ft² SITE CLASS I per 1992 DESIGN FLOW 480 gpd L.T.A.R. .03

Septic Tank: 1000 Gallons; STB PJ4 Bellinger Date 7-20-94

Pump Tank: 1000 Gallons; PT 27 Bellinger Date _____

Pump Make: Gould Model WES11 HA Serial No. 2887737

Nitrification Field: No Fields 1 Square Feet _____ Linear Feet 270

No Lines 4 Trench Width 24" Max Trench Bottom Depth 36" Gravel Depth N/A

☑ New System ☐ Repair System Type: I, II, III, ⓘ V, VI

System Description: LPPBPS

Repair System Description: Same

Maintenance Agreement Required: ☑ Yes ☐ No

☑ House/Mod. Home No. Bedrooms 4

☐ Mobile Home No. Bathrooms 2½

☐ Business No. Employees _____

☐ Other _____


☐ Slab ☑ Crawl Space ☐ Basement w/plumbing ☐ Basement wo/plumbing

Water Supply: ☐ Individual ☑ Community ☐ Public

Comments: ONE 3/16" hole per panel; 2' pressure head; trenches installed on contour

Comments:

INITIAL SITE SKETCH

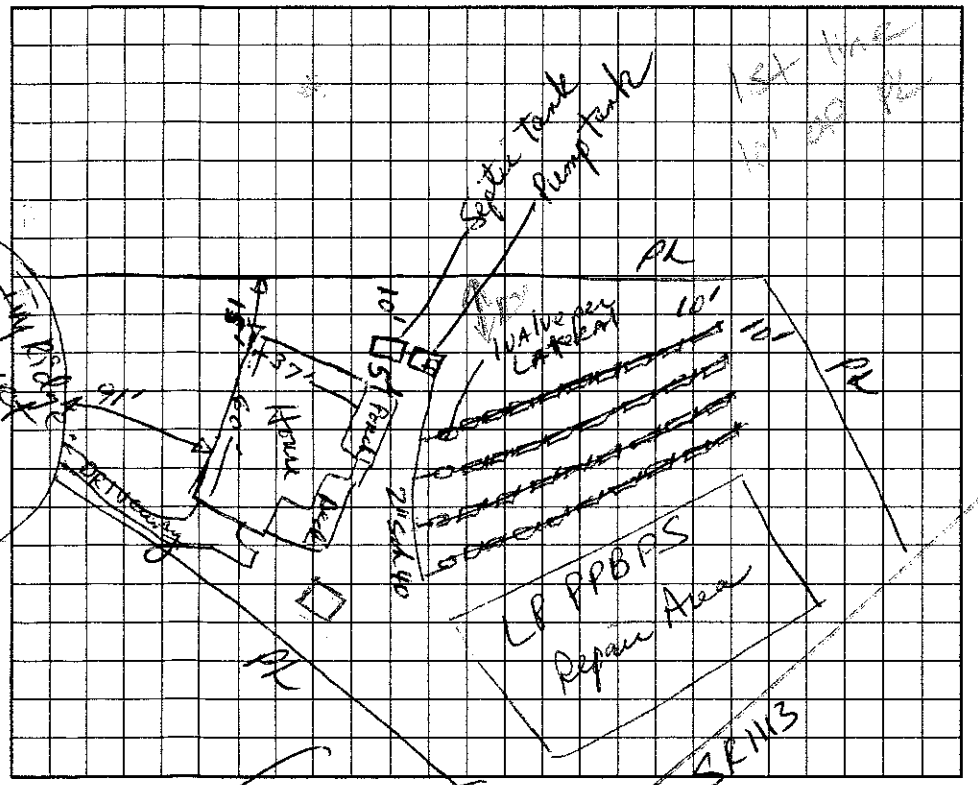

AS BUILT SKETCH

I understand that this permit can be suspended or revoked if any false information is supplied toward securing the permit/any unauthorized changes are made to the site/any unauthorized changes are made in the installation of the system. Improvement Permit is valid for 60 months from date of issuance.

Signed: _____

Improvement Permit by: Jack R. Stevenson, RS date 6/14/94

Existing System Inspection by: _____ date _____

Installed by: Robinson

Certificate of Completion by: _____ date _____

Operation Permit by: Jack R. Stevenson, RS date 10/10/94

HEALTH DEPT. COPY: WHITE INSPECTION COPY (FINAL): GREEN OWNER COPY (FINAL): YELLOW INSPECTION COPY (INITIAL): PINK OWNER COPY (INITIAL): GOLD