4635 28 8806

IREDELL COUNTY HEALTH DEPARTMENT

STATESVILLE 704-878-5305 MOORESVILLE 704-664-5281

IMPROVEMENT PERMIT / CERTIFICATE OF COMPLETION / OPERATION PERMIT / EXISTING SYSTEM INSPECTION

PROPERTY DESCRIPTION NO. 17753 DATE Feb. 1, 194 TAX MAP NO. 2623A 72 Watershed: ☑ Yes ☐ No

OWNER OR CONTRACTOR MI Homes PHONE: Business 376-9800 Home

ADDRESS 1043 E. Morehead Charlotte

LOCATION 1160 TL 113 TR Waterford TL LAKE PINE on left

SUBDIVISION PINE Isle BLOCK / SECTION LOT 72 LOT AREA .59 ac SITE CLASS. Spec. 1956 DESIGN FLOW 400 gpd L.T.A.R. .3

Septic Tank: 1000 Gallons; STB 7-94 Delta-8 Date 4-22-94

Pump Tank: 1000 Gallons; PT 27 Delta-Q Date 4-18-94

Pump Make: Model Serial No. SN28058 10

Nitrification Field: No Fields 1 Square Feet Linear Feet 270

No Lines 3 Trench Width 24" Max Trench Bottom Depth 36" Gravel Depth NA

☑ New System ☐ Repair System Type: I, II, III, ☑ IV, V, VI

System Description: LP PDBPS

Repair System Description: SAME

Maintenance Agreement Required: ☑ Yes ☐ No

☑ House/Mod. Home No. Bedrooms 4

☐ Mobile Home No. Bathrooms 2½

☐ Business No. Employees

☐ Other


☐ Slab ☑ Crawl Space ☐ Basement w/plumbing ☐ Basement wo/plumbing

Water Supply: ☐ Individual ☑ Community ☐ Public


Comments: 62 panels total; ONE 3/16" hole per panel; 2' pressure head; Pump spec: 37 gal/min at approx. 20' head.

Comments:

INITIAL SITE SKETCH

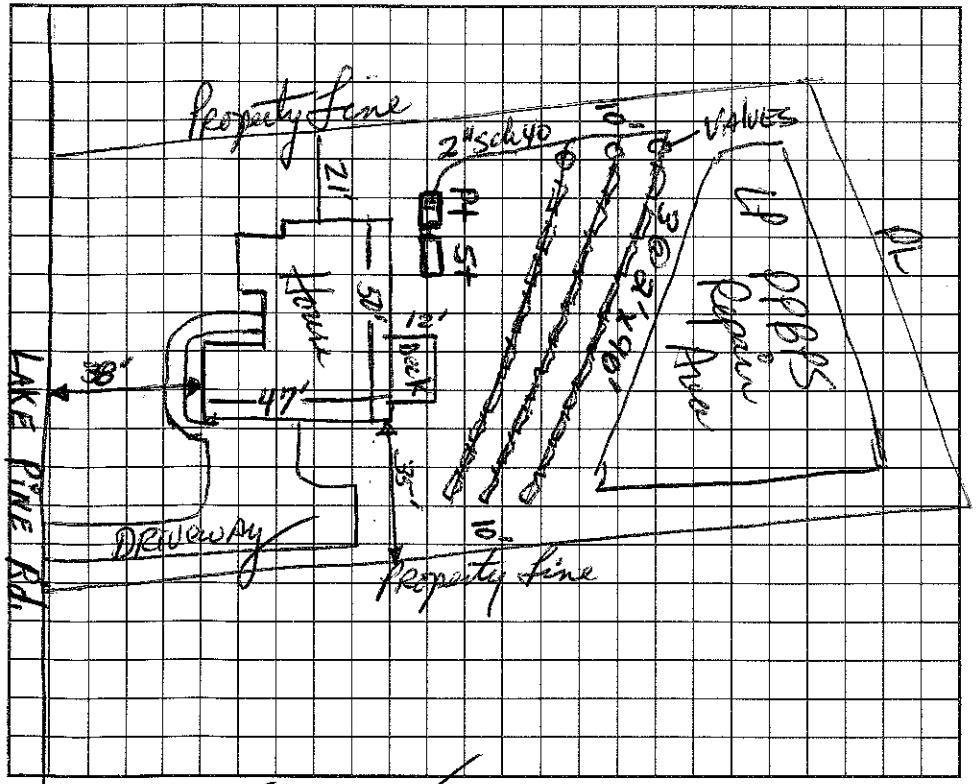

AS BUILT SKETCH

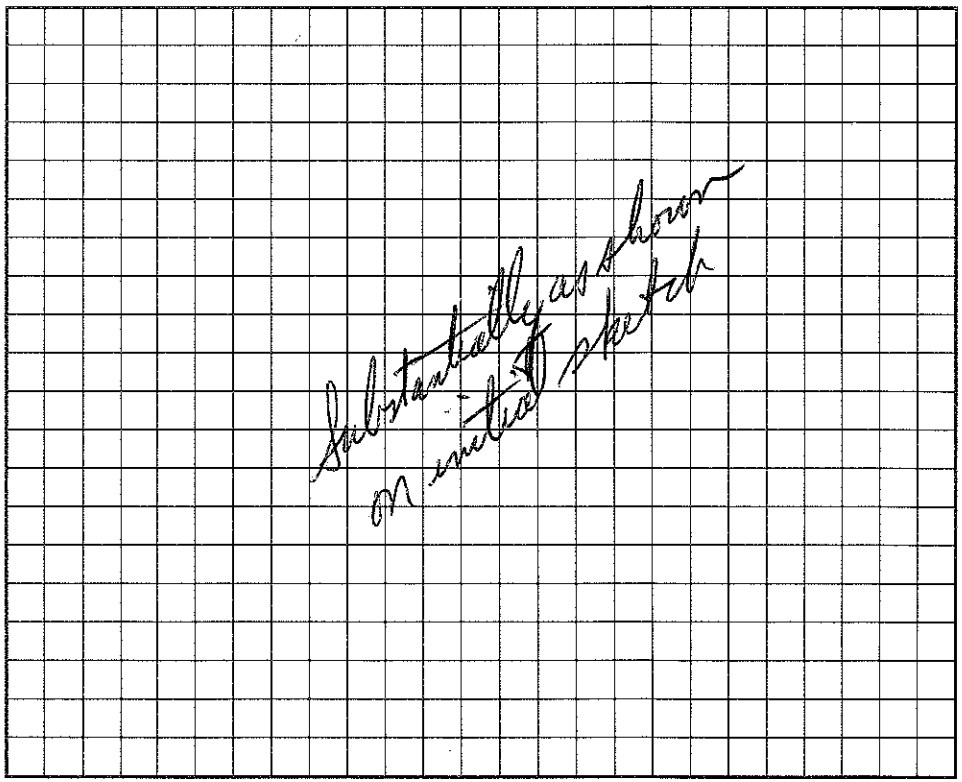

I understand that this permit can be suspended or revoked if any false information is supplied toward securing the permit/any unauthorized changes are made to the site/any unauthorized changes are made in the installation of the system. Improvement Permit is valid for 60 months from date of issuance.

Signed: [signature]

Improvement Permit by: David R. Hinson, RS date 2/1/94

Existing System Inspection by: date

Installed by: Osborn

Certificate of Completion by: date

Operation Permit by: David R. Hinson RS date 6/17/94

HEALTH DEPT. COPY: WHITE INSPECTION COPY (FINAL): GREEN OWNER COPY (FINAL): YELLOW INSPECTION COPY (INITIAL): PINK OWNER COPY (INITIAL): GOLD