IREDELL COUNTY HEALTH DEPARTMENT

4635 28 8906

STATESVILLE 704-878-5305 MOORESVILLE 704-664-5281

IMPROVEMENT PERMIT / CERTIFICATE OF COMPLETION / OPERATION PERMIT / EXISTING SYSTEM INSPECTION

PROPERTY DESCRIPTION NO. 17758 DATE Feb 16, '94 TAX MAP NO. 2623A73 Watershed: ☑ Yes ☐ No

OWNER OR CONTRACTOR MI Homes PHONE: Business 376-9500 Home L.N.

ADDRESS 1043 E. Morehead Charlotte

LOCATION 1400 FL 113 TR Waterford TL LAKE PINE on left

SUBDIVISION PINE Isle BLOCK / SECTION LOT 73 LOT AREA .55 Ac SITE CLASS PS per .1956 DESIGN FLOW 480 gpd L.T.A.R. .025

Septic Tank: 1000 Gallons; STB 794 Dellinger Date 6-18-94

Pump Tank: 1000 Gallons; PT 27 Dellinger Date 6-10-94

Pump Make: Model Serial No.

Nitrification Field: No Fields 1 Square Feet Linear Feet 320

No Lines 4 Trench Width 24" Max Trench Bottom Depth 36" Gravel Depth NA

☑ New System ☐ Repair System Type: I, II, III, ⓘ, V, VI

System Description: LPPPPS

Repair System Description: SAME

Maintenance Agreement Required: ☑ Yes ☐ No

☑ House/Mod. Home No. Bedrooms 4

☐ Mobile Home No. Bathrooms 3½

☐ Business No. Employees

☐ Other


☐ Slab ☑ Crawl Space ☐ Basement w/plumbing ☐ Basement wo/plumbing

Water Supply: ☐ Individual ☑ Community ☐ Public


Comments: 74 panels total ; one 3/16" hole per panel; 3' pressure head ; follow contours w/ laterals Pump specs: 44 gal/min at approx 25' head Dose approx 200 ± 260 gal per 6 minute cycle

Comments: Tanks & drainfield checked 8-2-94. Alarm mounting & Elec box checked 9/6/94

INITIAL SITE SKETCH

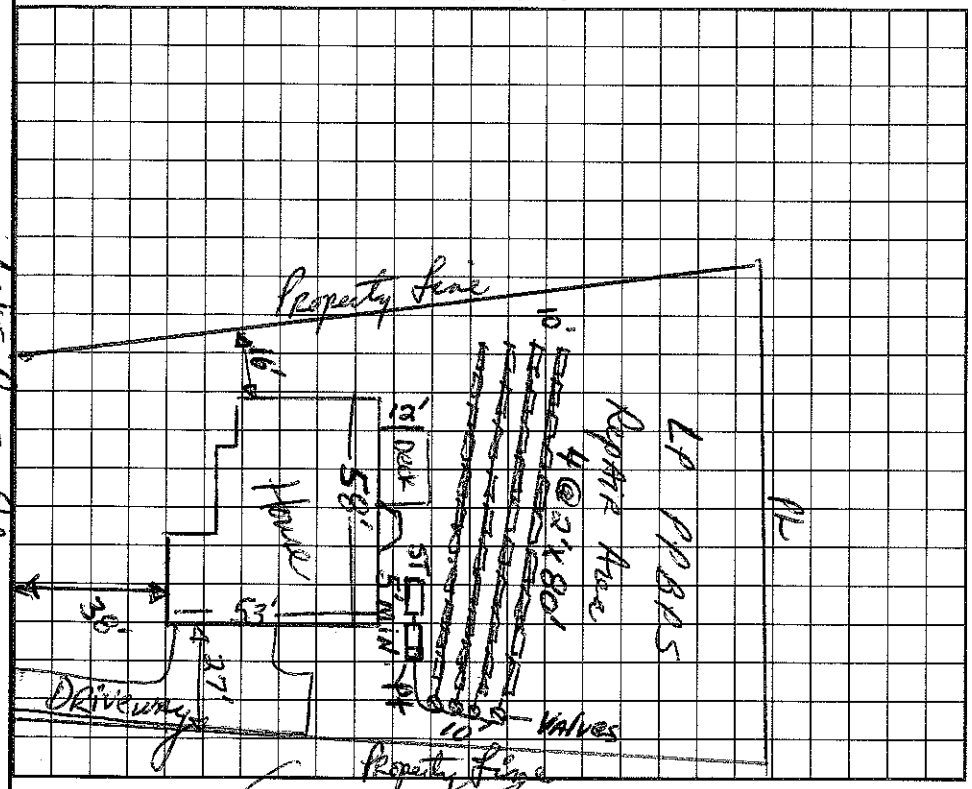

AS BUILT SKETCH

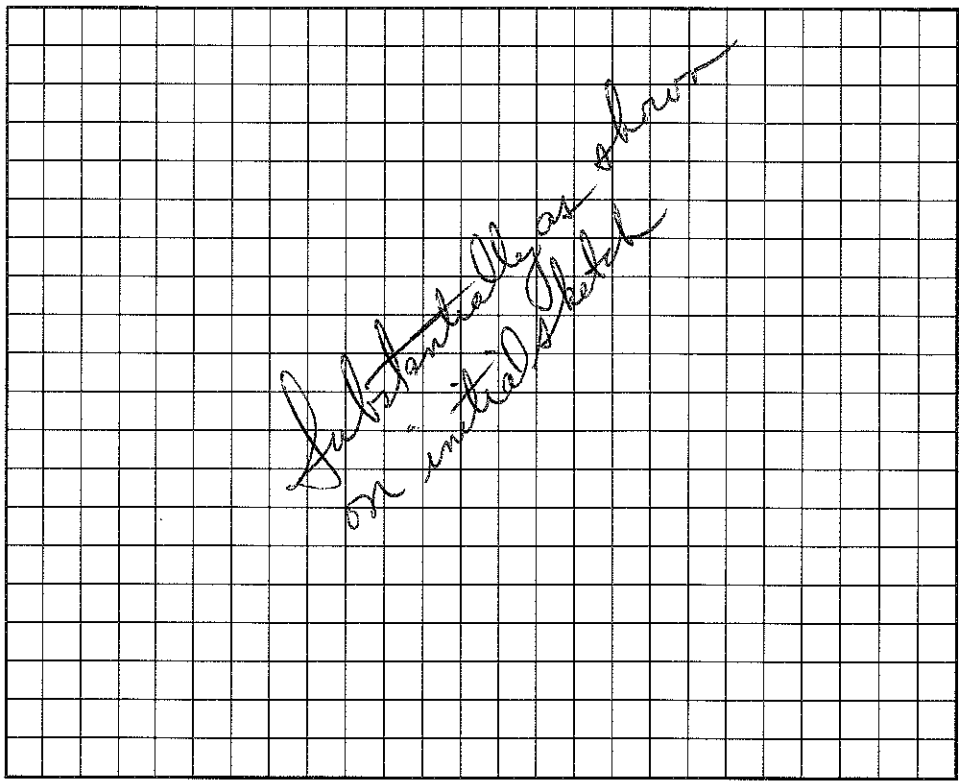

I understand that this permit can be suspended or revoked if any false information is supplied toward securing the permit/any unauthorized changes are made to the site/any unauthorized changes are made in the installation of the system. Improvement Permit is valid for 60 months from date of issuance.

Signed: [signature]

Improvement Permit by: [signature], RS date 2/16/94

Existing System Inspection by: date

Installed by: Owner

Certificate of Completion by: date

Operation Permit by: [signature], RS date 9/6/94

HEALTH DEPT. COPY: WHITE INSPECTION COPY (FINAL): GREEN OWNER COPY (FINAL): YELLOW INSPECTION COPY (INITIAL): PINK OWNER COPY (INITIAL): GOLD