IREDELL COUNTY HEALTH DEPARTMENT

STATESVILLE 704-878-5305 MOORESVILLE 704-664-5281

IMPROVEMENT PERMIT / CERTIFICATE OF COMPLETION / OPERATION PERMIT / EXISTING SYSTEM INSPECTION

PROPERTY DESCRIPTION NO. 17319 DATE Nov. 30, '93 TAX MAP NO. 2G23A 68 Watershed: ☐ Yes, ☐ No L.N.

OWNER OR CONTRACTOR M.I. Homes PHONE: Business 376-9800 Home

ADDRESS 1043 E. Morehead, Charlotte 4635-28-9414

LOCATION 110 Th 113 TR Waterford TL Rockenwood (Hickory) TL Ivy Ridge At End

SUBDIVISION Pine Lake BLOCK / SECTION 2 LOT 68 LOT AREA 34781 ft² SITE CLASS: PS per 1950 DESIGN FLOW 480 gpd L.T.A.R. .43

Septic Tank: 1000 Gallons; STB 358 ACP Date 12-1-93

Pump Tank: Gallons; PT Date

Pump Make: Model Serial No.

Nitrification Field: No Fields 1 Square Feet Linear Feet 270

No Lines 5 Trench Width 24" Max Trench Bottom Depth 36" Gravel Depth NA

☑ New System ☐ Repair System Type: I II III IV V VI

System Description: gravity PPBR

Repair System Description: pump conv. or PPBR

Maintenance Agreement Required: ☐ Yes ☑ No

☑ House/Mod. Home No. Bedrooms 4

☐ Mobile Home No. Bathrooms 2½

☐ Business No. Employees

☐ Other


☐ Slab ☑ Crawl Space ☐ Basement w/plumbing ☐ Basement wo/plumbing

Water Supply: ☐ Individual ☑ Community ☐ Public


Comments: Follow contour with Laterals

Comments: House plan reversed with driveway on right side without notifying this dept. However this did not cause a problem with septic system installation. DRAINFIELD installed in 4 LATERALS 1 @ 70' X 2' EACH

INITIAL SITE SKETCH

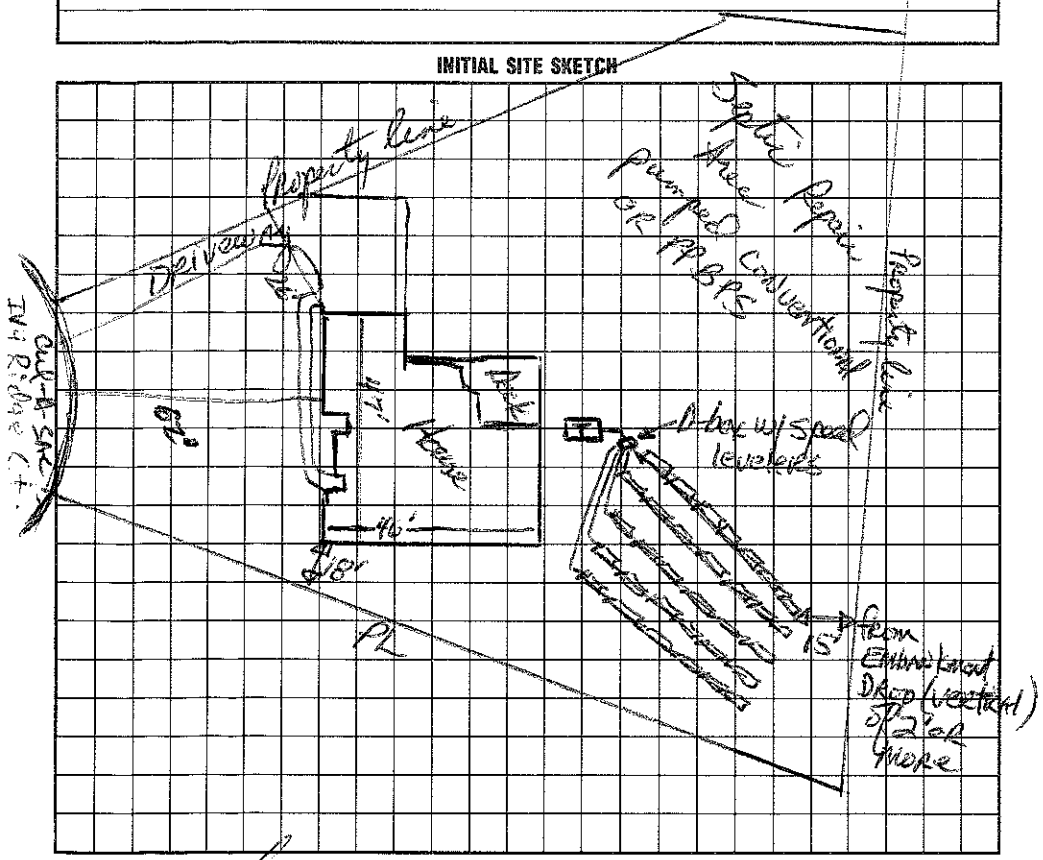

AS-BUILT SKETCH

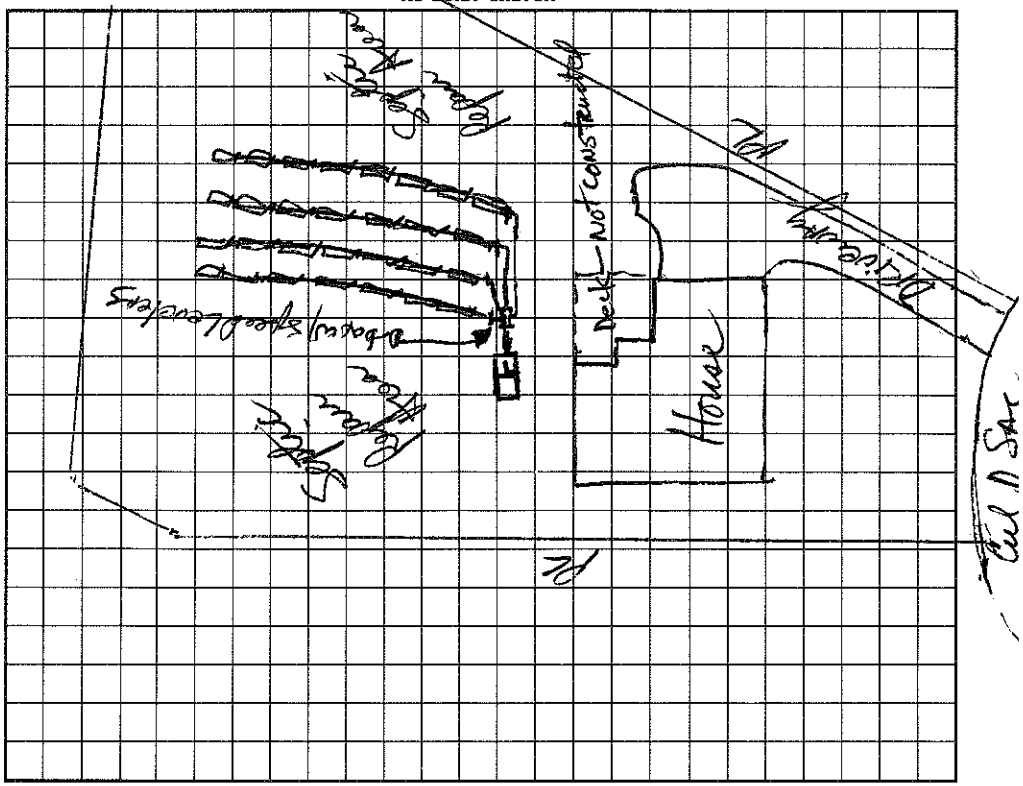

I understand that this permit can be suspended or revoked if any false information is supplied toward securing the permit/any unauthorized changes are made to the site/any unauthorized changes are made in the installation of the system. Improvement Permit is valid for 60 months from date of issuance.

Signed:

Improvement Permit by: Darrell Hinson, RS date 11/30/93

Existing System Inspection by: date

Installed by: Wayne Dubose

Certificate of Completion by: date

Operation Permit by: Darrell Hinson, RS date 1-25-94

HEALTH DEPT. COPY: WHITE INSPECTION COPY (FINAL): GREEN OWNER COPY (FINAL): YELLOW INSPECTION COPY (INITIAL): PINK OWNER COPY (INITIAL): GOLD