IREDELL COUNTY HEALTH DEPARTMENT

STATESVILLE 704-878-5305 MOORESVILLE 704-664-5281

IMPROVEMENT PERMIT / CERTIFICATE OF COMPLETION / OPERATION PERMIT / EXISTING SYSTEM INSPECTION

PROPERTY DESCRIPTION NO. 17523 DATE Dec 9, '93 TAX MAP NO. 2623A69 Watershed: ☑ Yes ☐ No L.N.

OWNER OR CONTRACTOR MI Homes PHONE: Business Home 4635-28-9547

ADDRESS 1043 E. Morehead, Charlotte

LOCATION 110 to FL 115 R Waterford TL Highview TL Ivy Ridge at END

SUBDIVISION Pine Isle BLOCK / SECTION 3 LOT 69 LOT AREA 30,605 SF SITE CLASS I Spn 1952 DESIGN FLOW 480 gpd L.T.A.R. .03

Septic Tank: 1000 Gallons; STB 794 Kellogg Date 3-11-94

Pump Tank: Gallons; PT Date

Pump Make: Model Serial No.

Nitrification Field: No Fields 1 Square Feet Linear Feet 270

No Lines 5 Trench Width 24" Max Trench Bottom Depth 36" Gravel Depth N/A

☑ New System ☐ Repair System Type: I, II, III, IV, V, VI

System Description: gravity 9"BR

Repair System Description: LC 1 YEARS

Maintenance Agreement Required: ☐ Yes ☑ No

☑ House/Mod. Home No. Bedrooms 4

☐ Mobile Home No. Bathrooms 3½

☐ Business No. Employees

☐ Other


☐ Slab ☑ Crawl Space ☐ Basement w/plumbing ☐ Basement wo/plumbing

Water Supply: ☐ Individual ☑ Community ☐ Public


Comments: Laterals to follow contour

Comments: System able to go in 4 trenches instead of 5.

INITIAL SITE SKETCH

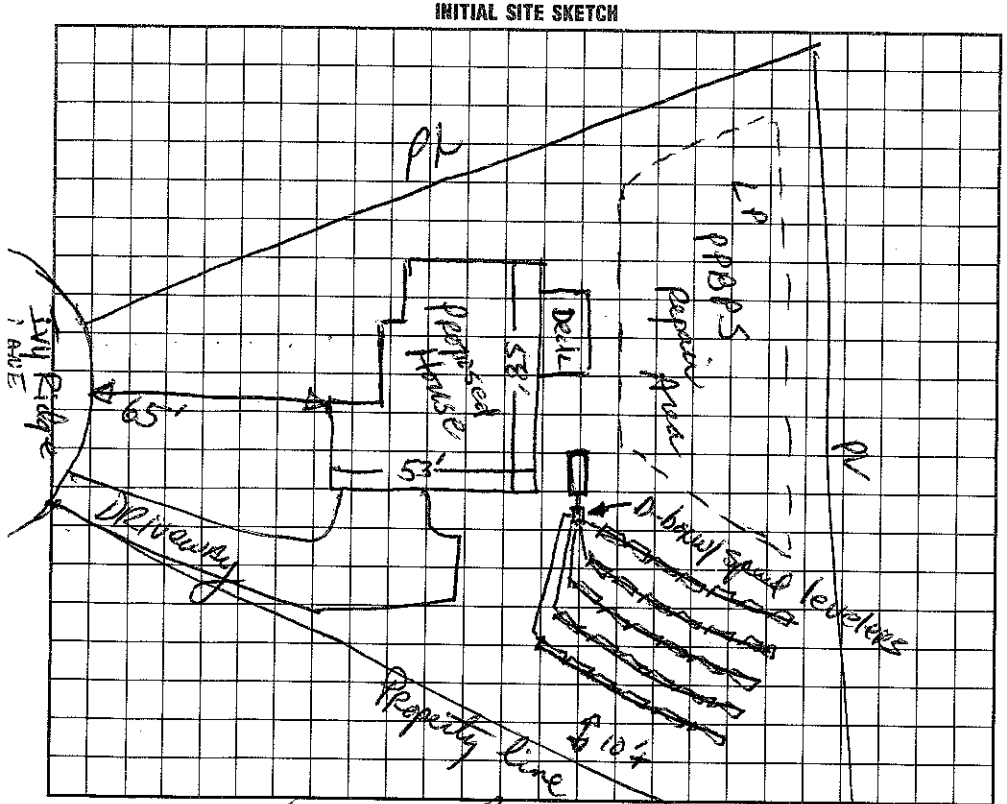

AS BUILT SKETCH

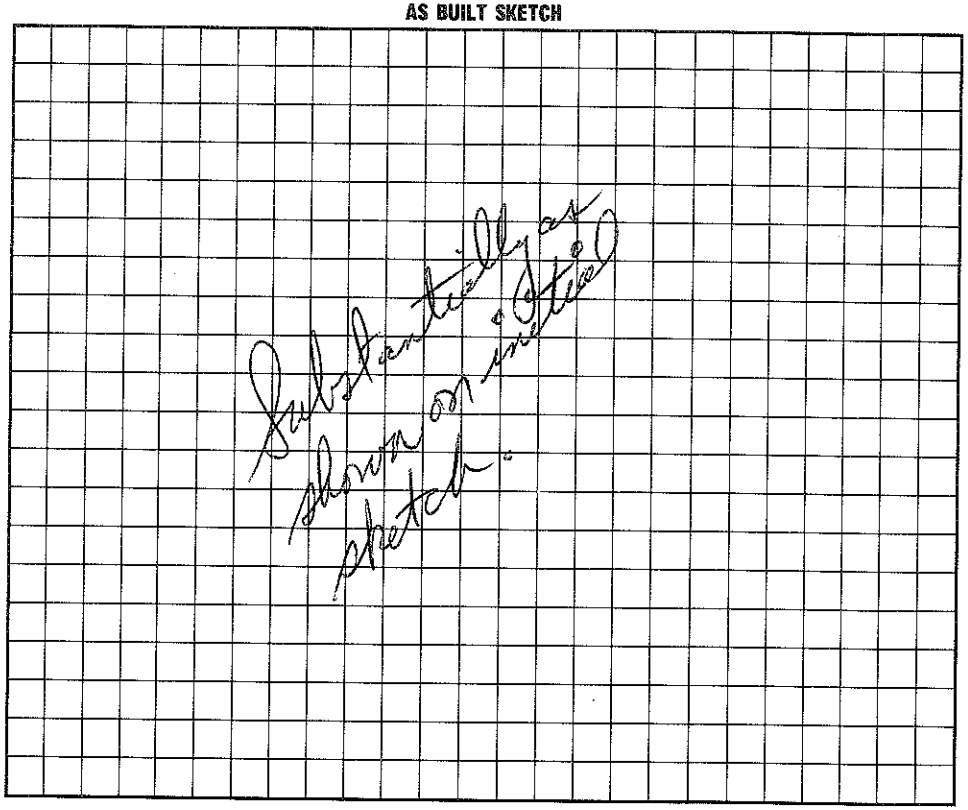

I understand that this permit can be suspended or revoked if any false information is supplied toward securing the permit/any unauthorized changes are made to the site/any unauthorized changes are made in the installation of the system. Improvement Permit is valid for 60 months from date of issuance.

Signed: X

Improvement Permit by: [signature] RS date 12/9/93

Existing System Inspection by: date

Installed by: Dalton

Certificate of Completion by: date

Operation Permit by: [signature] date 5/6/94

HEALTH DEPT. COPY: WHITE INSPECTION COPY (FINAL): GREEN OWNER COPY (FINAL): YELLOW INSPECTION COPY (INITIAL): PINK OWNER COPY (INITIAL): GOLD