4635290902

IREDELL COUNTY HEALTH DEPARTMENT

13943

IMPROVEMENT PERMIT AND CERTIFICATE OF COMPLETION / OPERATIONS PERMIT

OWNER OR CONTRACTOR M.I. Homes DATE 7/9/92 PERMIT NO 2623A27

PHONE: Business _____ Home _____

LOCATION 1100 TR 1113 TR into Pine Dale on right

S.R. No. _____

SUBDIVISION NAME Pine Dale LOT NO. 27 SECTION OR BLOCK NO. _____

House ☑ Mobile Home ☐ Business ☐ Other _____

No. Bedrooms 4 No. Bathrooms 2.5

Garbage Disposal Unit Yes ☐ No ☑

Auto. Dishwasher Yes ☑ No ☐

Auto. Wash. Machine Yes ☑ No ☐

Lot Area .66AC

Soil Characteristics PS clay


Application Rate .4

Topography 2 4%

Depth to Water Table 2 48"

Rock or other impervious formations NONE OBS

_____ Basement with Plumbing _____ Basement without Plumbing _____ ✓ No Basement _____ ✓ Crawl Space

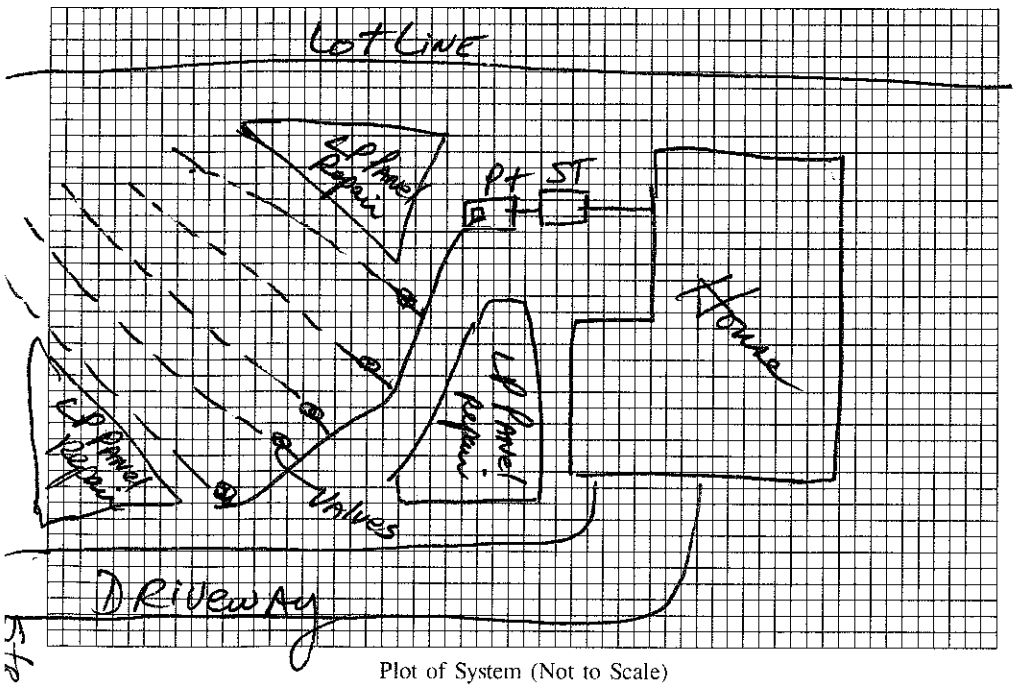

Plot of System (Not to Scale)

Size of Tank 1000/1000 Gals.

Nitrification Field:

No. of Lines 5

Sq. Ft. 1224 Linear Ft. 408

Depth of Stone in Lines 12"

Water Supply: Individual ☐

Public ☑ CW

Installed by Williams S.T. Monroe, NC

I understand and agree to install a septic tank system as specified on this Improvement Permit.

Signed: _____

(IMPROVEMENT PERMIT IS VALID FOR 60 MONTHS FROM DATE OF ISSUE.)

IMPROVEMENT PERMIT BY AWS

COMMENTS The 3 repair areas shown above should total enough area to accomodate 200-250 'of LP Panel. Installation of more conventional trenches would have used up repair area. Operations permit

CERTIFICATE OF COMPLETION BY Jarick R Johnson R.S. DATE 7/9/92

EXISTING SYSTEM CHECKED BY _____ DATE _____

CONSTRUCTION MUST COMPLY WITH ALL OTHER APPLICABLE STATE AND LOCAL REGULATIONS

Permit is VOID if any unauthorized changes are made in installation of system, and/or if any unapproved changes are made to the site, and/or if any false information is supplied toward securing Improvement Permit.

Health Dept. Copy: White Inspection Dept. Copy: Yellow Sanitarian's Copy: Pink Owner's Copy: Gold

This system was installed on June 19, '92 - Alarm had to be moved from crawlspace to garage & was rechecked on 7/9/92 DAH