4635 29 ~~304~~ 1073

IREDELL COUNTY HEALTH DEPARTMENT

STATESVILLE 704-878-5305 MOORESVILLE 704-664-5281

IMPROVEMENT PERMIT / CERTIFICATE OF COMPLETION / OPERATION PERMIT / EXISTING SYSTEM INSPECTION

PROPERTY DESCRIPTION NO. 17016 DATE Oct. 25, '93 TAX MAP NO. 2623A54 Watershed: ☑ Yes ☐ No L.N.

OWNER OR CONTRACTOR M I Homes PHONE: Business 376-9800 Home

ADDRESS 1043 E. Morehead #105, Charlotte NC 28204

LOCATION 1100 TL 1113 TR Waterford TL Rocksummon TR Harborshire on left AT END

SUBDIVISION Pine Hills BLOCK / SECTION LOT 54 LOT AREA ~3/4 Ac SITE CLASS. 15 per 1956 DESIGN FLOW 480 gpd L.T.A.R. .25 LPPBPS / .15 LPP

Septic Tank: 1000 Gallons; STB 358 ACP Date 1-6-94

Pump Tank: 1000 Gallons; PT 103 ACP Date -93

Pump Make: Goulds Model WE05111HH Serial No. 2805 795

Nitrification Field: No Fields 1 Square Feet Linear Feet 320

No Lines 5-6 Trench Width 24" Max Trench Bottom Depth 28" Gravel Depth NA

☑ New System ☐ Repair System Type: I, II, III, ⓘ V, VI

System Description: LP PPBPS

Repair System Description: LP PPBPS + LPP

Maintenance Agreement Required: ☑ Yes ☐ No

☑ House/Mod. Home No. Bedrooms 4

☐ Mobile Home No. Bathrooms 3½

☐ Business No. Employees

☐ Other

☐ Slab ☑ Crawl Space ☐ Basement w/plumbing ☐ Basement wo/plumbing

Water Supply: ☐ Individual ☑ Community ☐ Public

Comments:


Lake Norman

No grading / cutting of soil around home site.

* On Site consultation required w/ Septic installer prior to constructing system.

Comments: Water line not installed as of 4/12/94

INITIAL SITE SKETCH

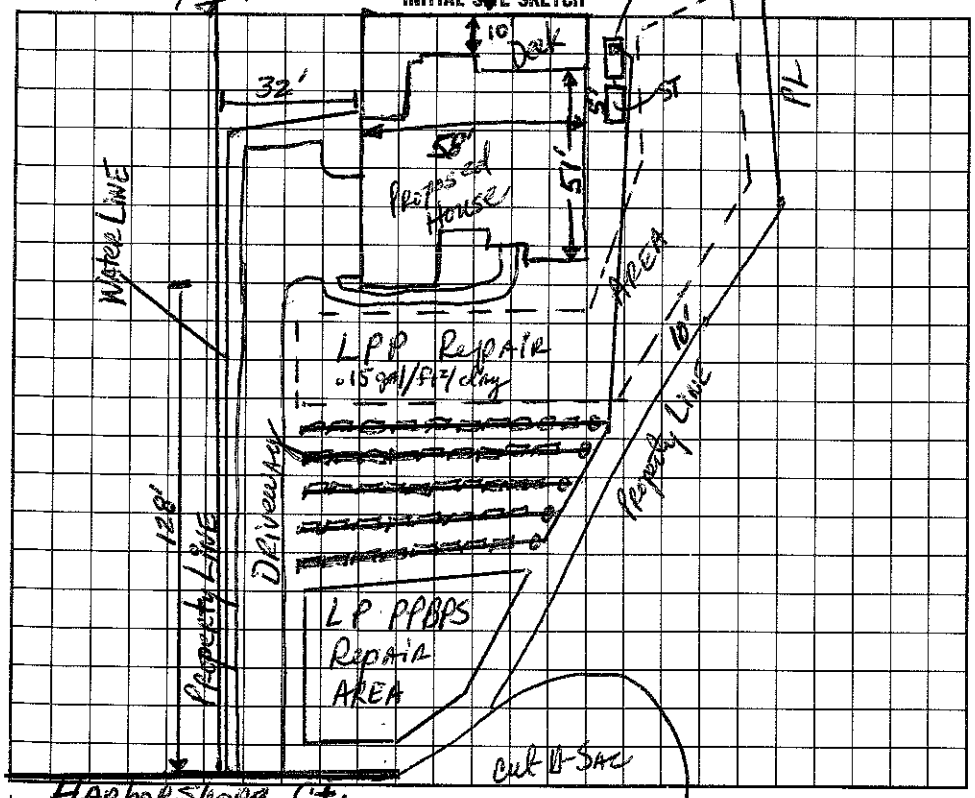

AS BUILT SKETCH

Substantially as shown on initial sketch.

I understand that this permit can be suspended or revoked if any false information is supplied toward securing the permit/any unauthorized changes are made to the site/any unauthorized changes are made in the installation of the system. Improvement Permit is valid for 60 months from date of issuance.

Signed: X

Improvement Permit by: David R. Hanson, RS date 10/25/93

Existing System Inspection by: date

Installed by: Owner

Certificate of Completion by: date

Operation Permit by: David R. Hanson, RS date 5/10/94

HEALTH DEPT. COPY: WHITE INSPECTION COPY (FINAL): GREEN OWNER COPY (FINAL): YELLOW INSPECTION COPY (INITIAL): PINK OWNER COPY (INITIAL): GOLD