IREDELL COUNTY HEALTH DEPARTMENT - *ENVIRONMENTAL HEALTH* ☐ STATESVILLE OFFICE 704-878-5305 ☐ MOORESVILLE OFFICE 704-664-5281

IMPROVEMENT PERMIT / AUTHORIZATION TO CONSTRUCT / OPERATION PERMIT / EXISTING SYSTEM INSPECTION

PERMIT # Repair PIN # 4635292328 DATE 3-27-2012

OWNER Tammy Senvisky APPLICANT: Same PHONE: Home/Cell # 7047246158 Business # Brad 7043619707

SITE ADDRESS 1160 Harbor Shore Ct Mill OWNER / APPLICANT ADDRESS Same

SITE DIRECTIONS Brawley School Rd TL Isle of Pines TR Waterford TL Lake Pine TR Harbor Shore Ct

SUBDIVISION Pine Isle BLOCK / SECTION LOT # 49 LOT AREA DESIGN FLOW 600gpd L.T.A.R. .3Rep/.35Init

5/25/12 Septic Tank 1500 g Gallons: STB Date
Pump Tank 1500 g Gallons: P T Date
Pump Make Myers Model ME45 Serial #
No. Nitrification Fields: 2 No. Lines 5 Linear Feet 340'
Trench Width min 24" Max. Trench Bottom Depth 36" Gravel Depth N/A

☐ New System ☒ Repair ☒ Expansion System Type I II III IV V VI
System Description: Pump-LP-Panel Block
Repair System Description: Pump-LP-Panel Blk (50% Red)
Maintenance Agreement Required ☒ YES ☐ NO
☐ GRAVITY ☒ PRESSURE


☒ Residence No. Bedrooms 5
☐ Business No. Persons
☐ Other No. Employees
☐ Slab ☒ Crawl Space
☐ Basement w/plumbing ☐ Basement w/o plumbing

Water Supply: ☐ Private ☐ Public ☒ Community


Comments / Conditions: Install 4 lines @ 85ft ea (50% Reduction for Repair to 5 Bedroom. Egg Distribution with Central Gate Valve Box & 1 tanks are 1500g. & structurally sound then Okay to reuse

Add 70ft (2-lines @ 35ft) to Upgrade Existing/Original Drainfield to 5 Bedroom. Use Central Gate Valve Box - Install Valve(s) in Supply line to switch between Drainfields

INITIAL SITE SKETCH

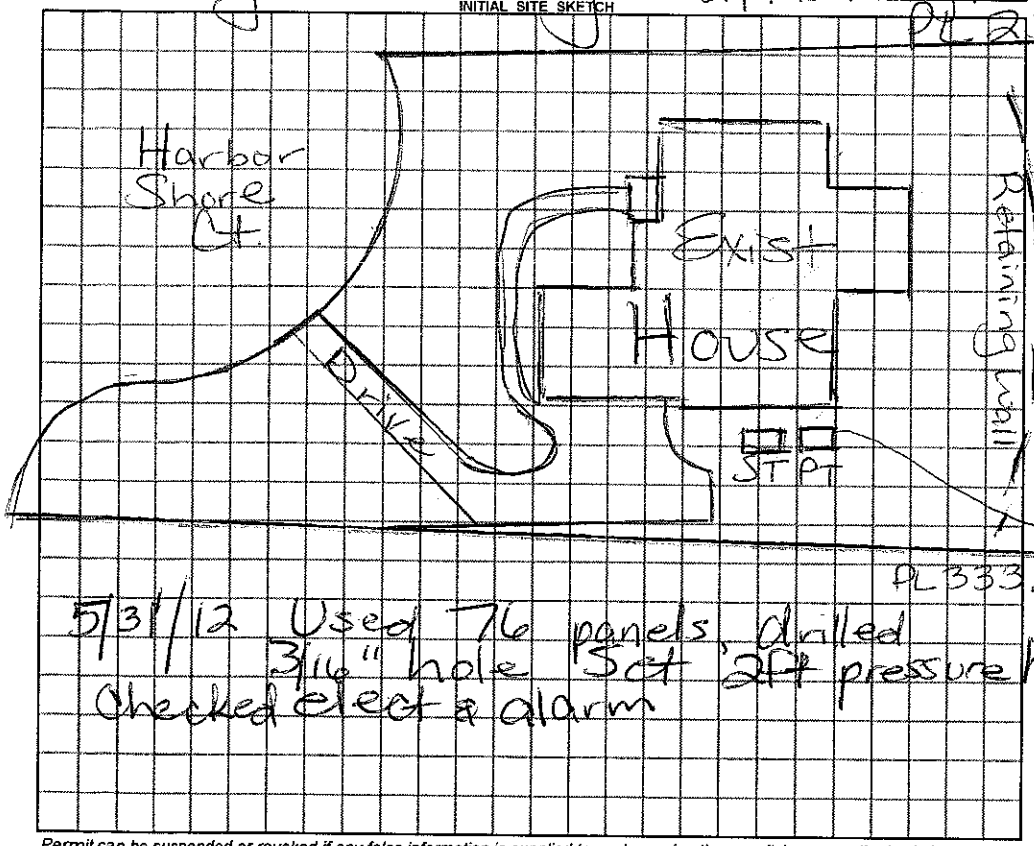

AS BUILT SKETCH

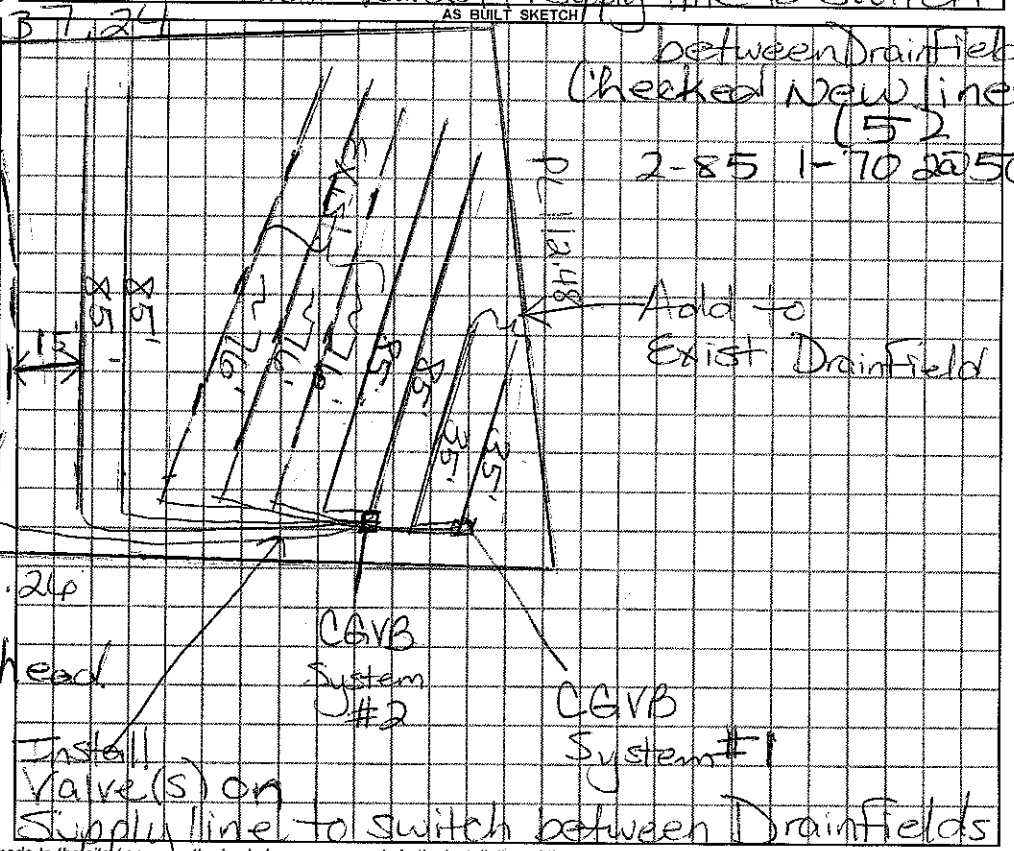

5/31/12 Used T76 panels, drilled 3/16" hole Set 2ft pressure head Checked elect & alarm

Permit can be suspended or revoked if any false information is supplied toward securing the permit / any unauthorized changes are made to the site / any unauthorized changes are made in the installation of the system.

☐ ***IMPROVEMENT PERMIT*** with plat valid without expiration. ☐ ***IMPROVEMENT PERMIT*** with plat valid without expiration. site plan valid 60 mo. ☒ ***AUTHORIZATION TO CONSTRUCT*** valid for period equal to IMPROVEMENT PERMIT--not to exceed 60 mo.

Owner / Applicant Signature: Tammy Harrell Date 3-29-12 Installed by: R & H

IMPROVEMENT PERMIT by: Marie Hix-Cloer ***REHS*** Date 3/27/2012 OPERATION PERMIT by: Marie Hix-Cloer ***REHS*** Date 7/3/12

AUTHORIZATION TO CONSTRUCT by: Marie Hix-Cloer ***REHS*** Date 3/27/2012 Existing System Inspected by: ***REHS*** Date

YOU SHOULD CONTACT A LOCATOR SERVICE PRIOR TO ANY EXCAVATION

White Copy – Environmental Health YELLOW COPY (Final) Owner / Applicant PINK COPY (Initial) Owner / Applicant