IREDELL COUNTY HEALTH DEPARTMENT

Statesville Office (704) 878-5305 Mooresville Office (704) 660-3625 PERMIT # 221367

IMPROVEMENT PERMIT / AUTHORIZATION TO CONSTRUCT / OPERATION PERMIT / EXISTING SYSTEM

PIN # 4635-29-2903

APPLICANT: RICK GORANOWSKI APPLICANT ADDRESS: 126 WATERFORD DR. - MOORESVILLE

SITE ADDRESS: SAME PHONE: 704-430-8534 ALT. PHONE:

SITE DIRECTIONS: BSR, STUTTS, TR TURRYFILL, TL ISLE OF PINES, TR WATERFORD, 4TH ON R

SUBDIVISION: PINE ISLE SECTION: -/- LOT # 26 LOT AREA: .68 AC DESIGN FLOW: 480 L.T.A.R.:

Septic Tank	1000 (gal)	STB	760	Date	7-5-16	☐ New System	☑ Repair	☐ Expansion	System Type: I II III (IV) V VI	☑ Residence	No. Bedrooms 4
Pump Tank	Ex. 1500 (gal)	PT		Date		System Description:				☐ Business	No. Persons 8
Pump Make		Model		Serial #		Repair System Description:	TANK			☐ Other	No. Employees
# Nitrification Fields	# Lines			Linear Ft:		Maintenance Agreement Required:	☑ YES	☐ NO		☐ Slab	☑ Crawl Space
Trench Width	Max. Trench Bottom Depth			Gravel Depth	—		☐ GRAVITY	☑ PRESSURE		☐ Basement w/plumbing	☐ Basement w/o plumbing

EXISTING


Water Supply: ☐ Private ☐ Public ☑ Community

Comments / Conditions:


Soil Fax

224

INITIAL SITE SKETCH

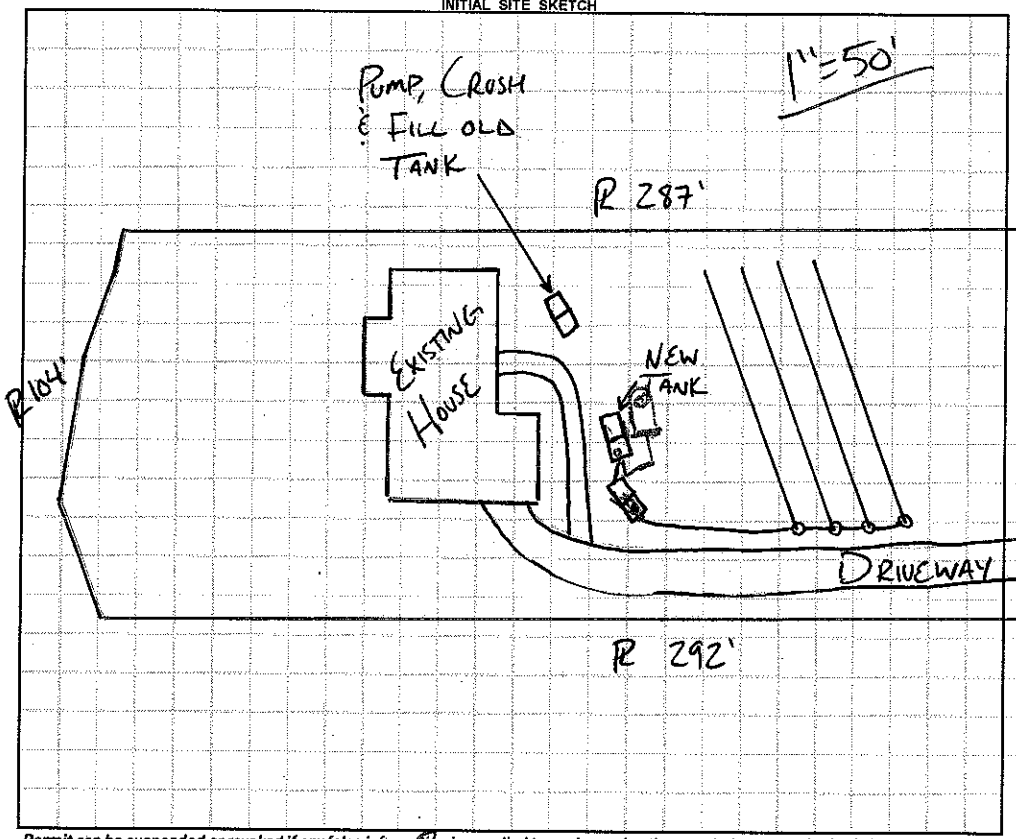

AS BUILT SKETCH

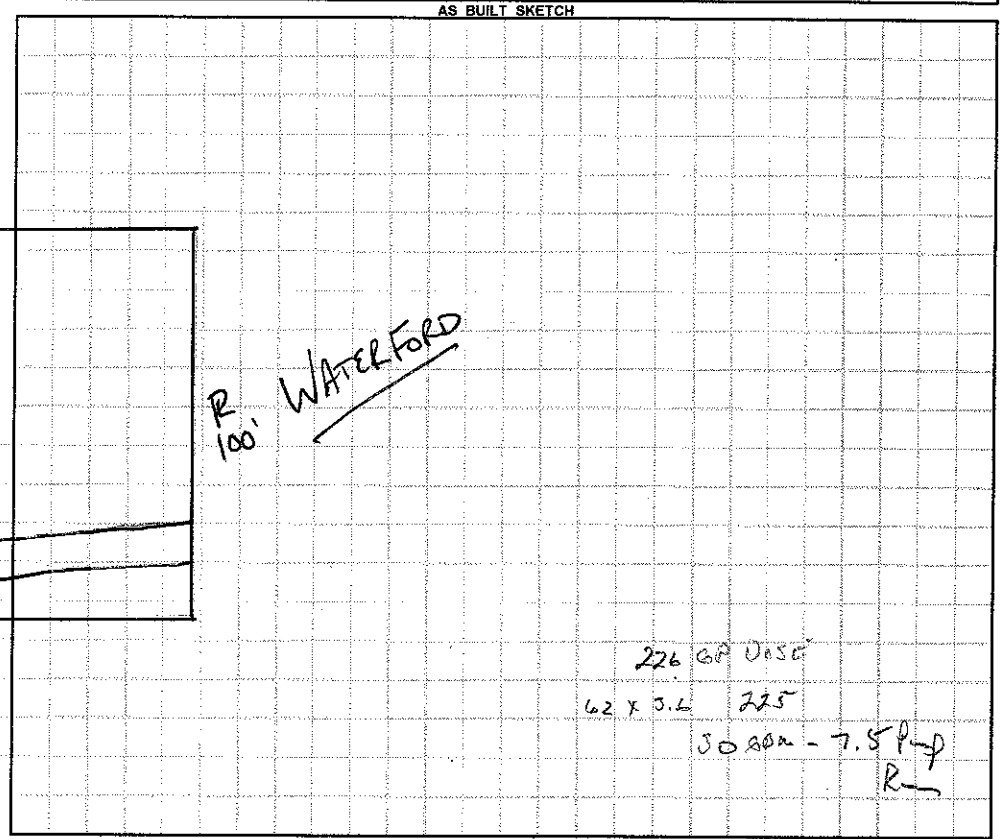

Permit can be suspended or revoked if any false information is supplied toward securing the permit / any unauthorized changes are made to the site / any unauthorized changes are made in the installation of the system. **CONTACT A LOCATOR SERVICE PRIOR TO ANY EXCAVATION**

☐ **IMPROVEMENT PERMIT** *with plat valid without expiration.* ☑ **IMPROVEMENT PERMIT** *with site plan valid for 60 mos.* ☑ **AUTHORIZATION TO CONSTRUCT** *valid for period equal to IMPROVEMENT PERMIT--not to exceed 60 mo.*

Owner / Applicant Signature: Date: Installed by: Lentz Water Well

IMPROVEMENT PERMIT by: APPROVED Date: SEP 02 2016 OPERATION PERMIT by: Date: 9/13/16

AUTHORIZATION TO CONSTRUCT by: APPROVED Date: SEP 02 2016 Existing System Inspected by: Date:

Health Dept. Copy - WHITE Applicant (Final Approval) - YELLOW Applicant (Conditional Approval) - PINK