IREDELL COUNTY HEALTH DEPARTMENT

STATESVILLE 704-878-5305 MOORESVILLE 704-664-5281

IMPROVEMENT PERMIT / CERTIFICATE OF COMPLETION / OPERATION PERMIT / EXISTING SYSTEM INSPECTION

PROPERTY DESCRIPTION NO. 17760 DATE Feb 15, '94 TAX MAP NO. 2G23A45 Watershed: ☑ Yes ☐ No L.N.

OWNER OR CONTRACTOR MI Homes PHONE: Business 376-9800 Home

ADDRESS 1043 E. Morehead Charlotte 4635-29-3589

LOCATION 1100 TL 1113 TR Waterford TL Lake Pine 2nd lot on Rt.

SUBDIVISION Pine Isle BLOCK / SECTION LOT 45 LOT AREA ~102' X 234' SITE CLASS. B per 1953 DESIGN FLOW 450 gpd L.T.A.R. .3

Septic Tank: 1000 Gallons; STB "794 Hellinger Date 6-17-94

Pump Tank: Gallons; PT Date

Pump Make: Model Serial No.

Nitrification Field: No Fields 1 Square Feet Linear Feet 270

No Lines 4 Trench Width 24" Max Trench Bottom Depth 36" Gravel Depth NA

☑ New System ☐ Repair System Type: I, II, ☑ III, IV, V, VI

System Description: gravity PPBPS

Repair System Description: SAME

Maintenance Agreement Required: ☐ Yes ☑ No

☑ House/Mod. Home No. Bedrooms 4

☐ Mobile Home No. Bathrooms 2½

☐ Business No. Employees

☐ Other


☐ Slab ☑ Crawl Space ☐ Basement w/plumbing ☐ Basement wo/plumbing

Water Supply: ☐ Individual ☑ Community ☐ Public


Comments: Follow contour with Caterals

Comments: Upon arrival for system inspection it was found that entrance to garage had been changed to rear entry without proper approval from H.D. Fortunately the Builder, there is still sufficient space for septic repair if ever needed.

INITIAL SITE SKETCH

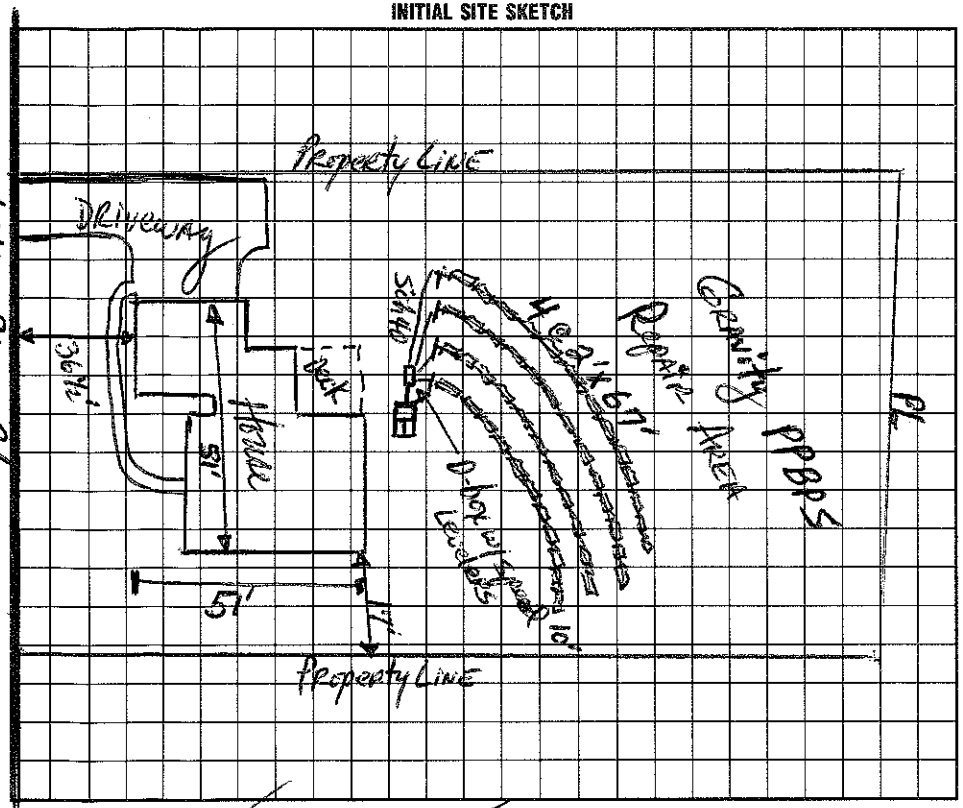

AS BUILT SKETCH

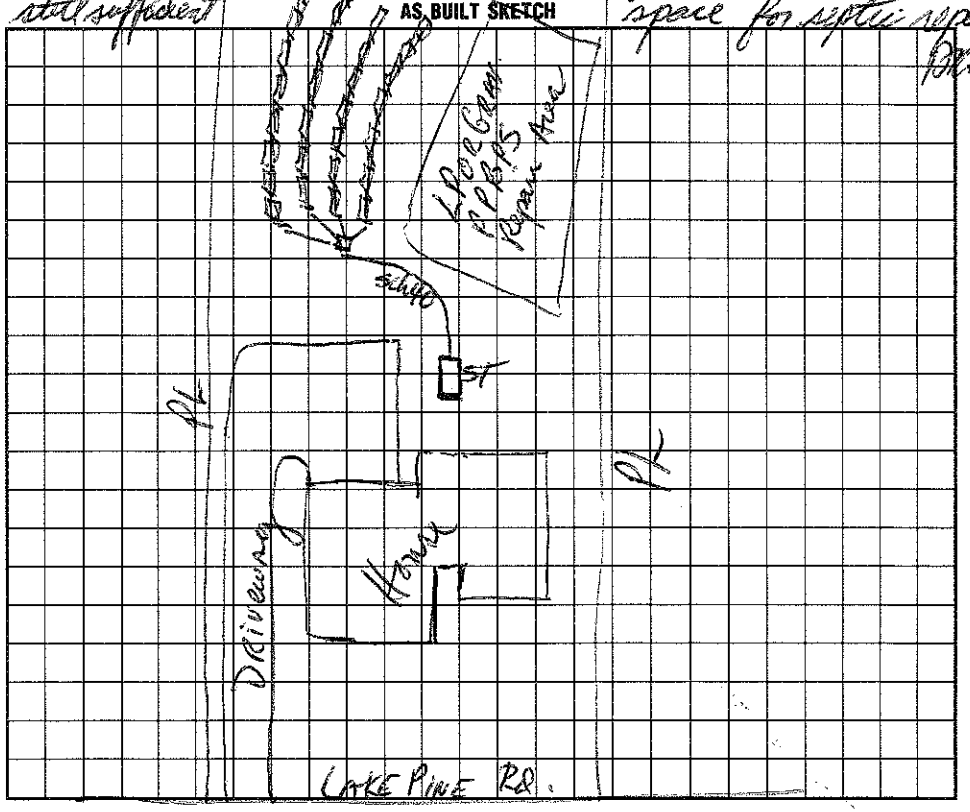

I understand that this permit can be suspended or revoked if any false information is supplied toward securing the permit/any unauthorized changes are made to the site/any unauthorized changes are made in the installation of the system. Improvement Permit is valid for 60 months from date of issuance.

Signed: X

Improvement Permit by: Patrick R Hinson, RS date 2/15/94

Existing System Inspection by: date

Installed by: Osbron

Certificate of Completion by: date

Operation Permit by: Patrick R Hinson, RS date 8/2/94

HEALTH DEPT. COPY: WHITE INSPECTION COPY (FINAL): GREEN OWNER COPY (FINAL): YELLOW INSPECTION COPY (INITIAL): PINK OWNER COPY (INITIAL): GOLD