IREDELL COUNTY HEALTH DEPARTMENT

STATESVILLE 704-878-5305 MOORESVILLE 704-664-5281

IMPROVEMENT PERMIT / CERTIFICATE OF COMPLETION / OPERATION PERMIT / EXISTING SYSTEM INSPECTION

PROPERTY DESCRIPTION NO. _____ DATE June 29, '93 TAX MAP NO. 2623 A57

OWNER OR CONTRACTOR M I Homes PHONE: Business 4635-29-5058 Home _____

ADDRESS 1043 E. Morehead St, Charlotte

LOCATION 1100 TL 1113 TR Waterford TL Highview on Right corner lot w/ Harborshore

SUBDIVISION Pine Isle BLOCK / SECTION _____ LOT 57 LOT AREA _____ SITE CLASS. _____ L.T.A.R. n/a

Water Supply: ☐ Individual ☑ Community ☐ Public

Septic Tank: Existing Gallons; STB _____ Date _____

Pump Tank: 0 Gallons; PT _____ Date _____

Nitrification Field: No Fields 2 (Ex + New) Square Feet _____ Linear Feet 270

No Lines 6 Trench Width 24" Trench Depth 36" Gravel Depth NA

☐ New System ☑ Repair System Type: I, II, III, IV, V, VI

System Description: gravity PPBPS PL

Repair System Description: gravity PPBPS

Maintenance Agreement Required: ☐ Yes ☑ No

☑ House/Mod. Home No. Bedrooms 4

☐ Mobile Home No. Bathrooms 2½

☐ Business No. Employees _____

☐ Other _____

☐ Slab ☑ Crawl Space ☐ Basement w/plumbing ☐ Basement wo/plumbing

Garbage Disposal: ☑ Yes ☐ No


Auto. Dishwasher: ☑ Yes ☐ No

Auto. Washing Machine: ☑ Yes ☐ No


Other _____

Comments 480 gpd maximum design flow. Install repair under dry conditions

INITIAL SITE SKETCH

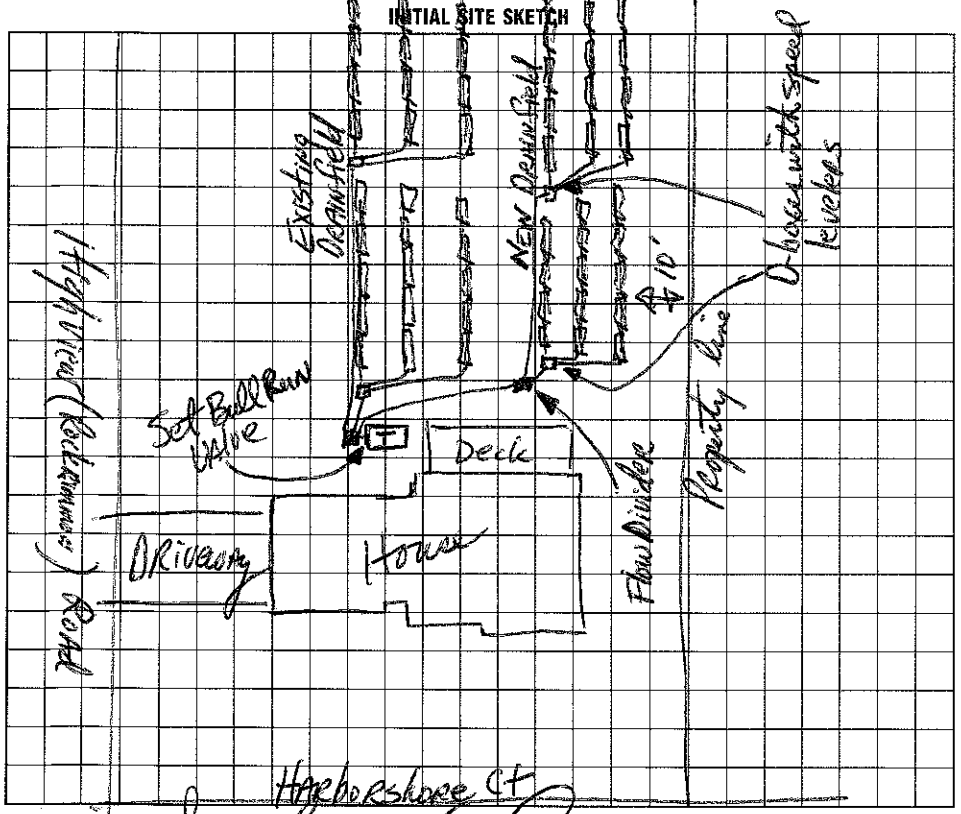

AS BUILT SKETCH

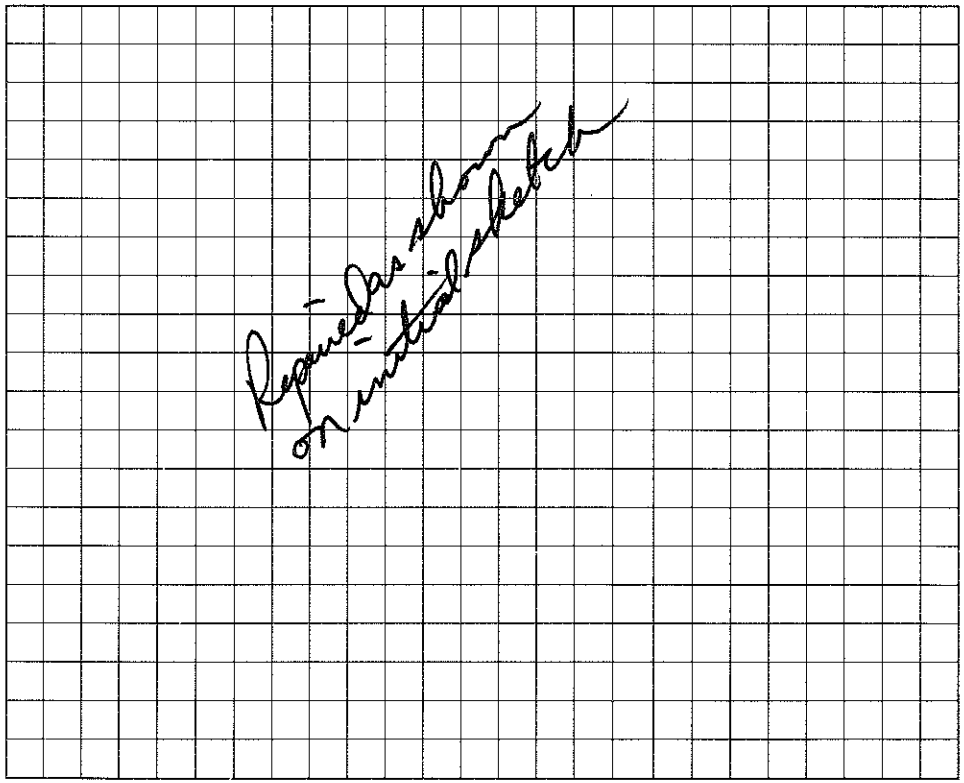

I understand that this permit can be suspended or revoked if any false information is supplied toward securing the permit/any unauthorized changes are made to the site/any unauthorized changes are made in the installation of the system. Improvement Permit is valid for 60 months from date of issuance.

Signed: X

Improvement Permit by: Jack R. Hanson, RS date 6/29/93

Existing System Inspection by: _____ date _____

Installed by: Owner

Certificate of Completion by: _____ date _____

Operation Permit by: Jack R. Hanson RS date 7/14/93

HEALTH DEPT. COPY: WHITE INSPECTION COPY (FINAL): GREEN OWNER COPY (FINAL): YELLOW INSPECTION COPY (INITIAL): PINK OWNER COPY (INITIAL): GOLD