IREDELL COUNTY HEALTH DEPARTMENT

STATESVILLE 704-878-5305 4635 29 6458 MOORESVILLE 704-664-5281

IMPROVEMENT PERMIT / CERTIFICATE OF COMPLETION / OPERATION PERMIT / EXISTING SYSTEM INSPECTION

PROPERTY DESCRIPTION NO. 16200 DATE Sept. 24, '93 TAX MAP NO. 2623A78

OWNER OR CONTRACTOR M I Homes PHONE: Business Home

ADDRESS 1043 E. Morehead, Charlotte

LOCATION 1100 TR 1113 TR Waterford TL Highview on left

SUBDIVISION Pine Isle BLOCK / SECTION 2 LOT 78 LOT AREA 25,000 ft² SITE CLASS 5 per 1956 L.T.A.R. .3

Water Supply: ☐ Individual ☑ Community ☐ Public Goulds ½ HP WE0511 HH

Septic Tank: 1500 Gallons; STB 780 ACP Date 4-29-93

Pump Tank: 1500 Gallons; PT 104 ACP Date 4-29-93

Nitrification Field: No Fields 1 Square Feet Linear Feet 270

No Lines 4 Trench Width 24" Trench Depth 28-32" Gravel Depth NA

☑ New System ☐ Repair System Type: I, II, III, IV, V, VI

System Description: LP PPBPS

Repair System Description: SAME

Maintenance Agreement Required: ☑ Yes ☐ No

☑ House/Mod. Home No. Bedrooms 4

☐ Mobile Home No. Bathrooms 2½

☐ Business No. Employees

☐ Other

☐ Slab ☑ Crawl Space ☐ Basement w/plumbing ☐ Basement wo/plumbing

Garbage Disposal: ☑ Yes ☐ No

Auto. Dishwasher: ☑ Yes ☐ No

Auto. Washing Machine: ☑ Yes ☐ No

Other


Comments Maintenance agreement received 9/24/93. System installed on 8/10/93. No Deck constructed as of 9/24/93.

PL

10'±

INITIAL SITE SKETCH

AS BUILT SKETCH

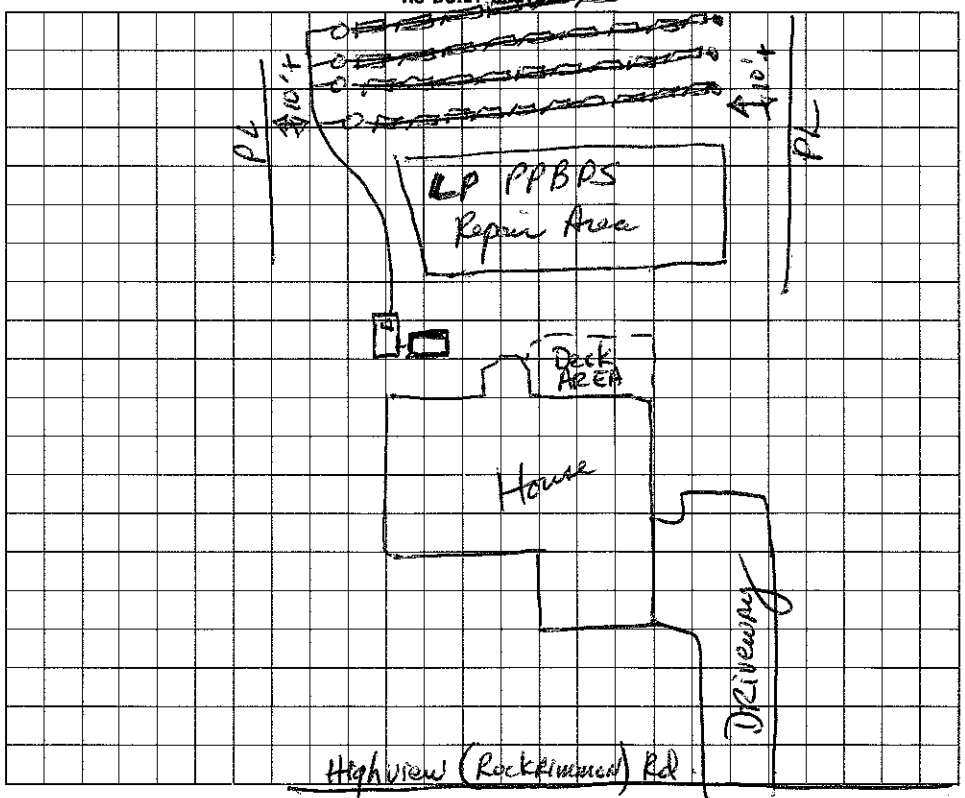

I understand that this permit can be suspended or revoked if any false information is supplied toward securing the permit/any unauthorized changes are made to the site/any unauthorized changes are made in the installation of the system. Improvement Permit is valid for 60 months from date of issuance.

Signed:

Improvement Permit by: date

Existing System Inspection by: date

Installed by:

Certificate of Completion by: date

Operation Permit by: James R Hanson, RS date 9/24/93

HEALTH DEPT. COPY: WHITE INSPECTION COPY (FINAL): GREEN OWNER COPY (FINAL): YELLOW INSPECTION COPY (INITIAL): PINK OWNER COPY (INITIAL): GOLD