John Peterson

IREDELL COUNTY HEALTH DEPARTMENT - ENVIRONMENTAL HEALTH ☐ STATESVILLE OFFICE 704-878-5305 ☐ MOORESVILLE OFFICE 704-664-5281

IMPROVEMENT PERMIT / AUTHORIZATION TO CONSTRUCT / OPERATION PERMIT / EXISTING SYSTEM INSPECTION

PERMIT # Repair BIN # 46352965 49 DATE 10-18-2011

OWNER Kate Overton APPLICANT: David Yountz PHONE: Home/Cell # 704 902 9352 Business # Kate 704 996-5969

SITE ADDRESS 109 Lake Pine Rd M'ville OWNER / APPLICANT ADDRESS 109 Lake Pine Rd M'ville, NC 28117

SITE DIRECTIONS Brawley School Rd TL Isle of Pines TR Waterford TL Lake Pine 2nd lot on left

SUBDIVISION Pine Isle BLOCK / SECTION 2 LOT # 79 LOT AREA .533 Ac DESIGN FLOW 360 gpd L.T.A.R. .3

Septic Tank 1000 Gallons: STB 1012 Date 10-12-10 ☐ New System, ☒ Repair ☐ Expansion System Type I II III (IV) V VI

Pump Tank 1000 Gallons: P T Date

Pump Make Model Serial #

No. Nitrification Fields: 1 No. Lines 3 Linear Feet 200 Ft

Trench Width 24" Max. Trench Bottom Depth 36" Gravel Depth N/A

System Description: See Note Pump-Panel Blk

Repair System Description: Some

Maintenance Agreement Required ☒ YES ☐ NO

☐ GRAVITY ☒ PRESSURE

☐ Residence No. Bedrooms

☐ Business No. Persons

☐ Other No. Employees

☐ Slab ☒ Crawl Space

☐ Basement w/plumbing ☐ Basement w/o plumbing

Water Supply: ☐ Private ☒ Public ☐ Community


Comments / Conditions: ★ Replace Cracked (in sound) Septic Tank. May have to shift ST location due to space. Must maintain gravity flow to ST

Must have current Maint Agreement with Cert W.W. Operator.

Filter installed, ST checked


INITIAL SITE SKETCH

Scale 1:40

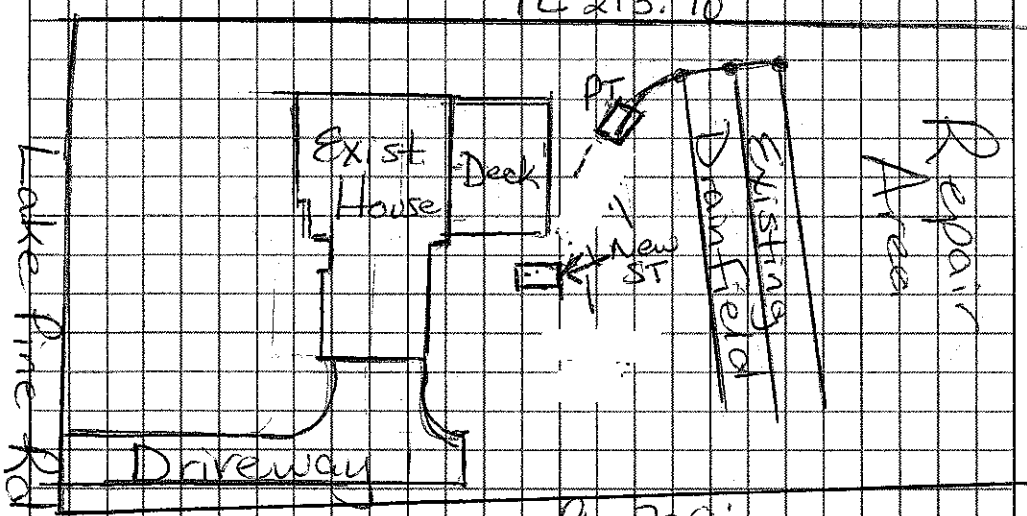

AS BUILT SKETCH

★ Must maintain Maintenance Agreement with Cert. Operator for Type 4 System

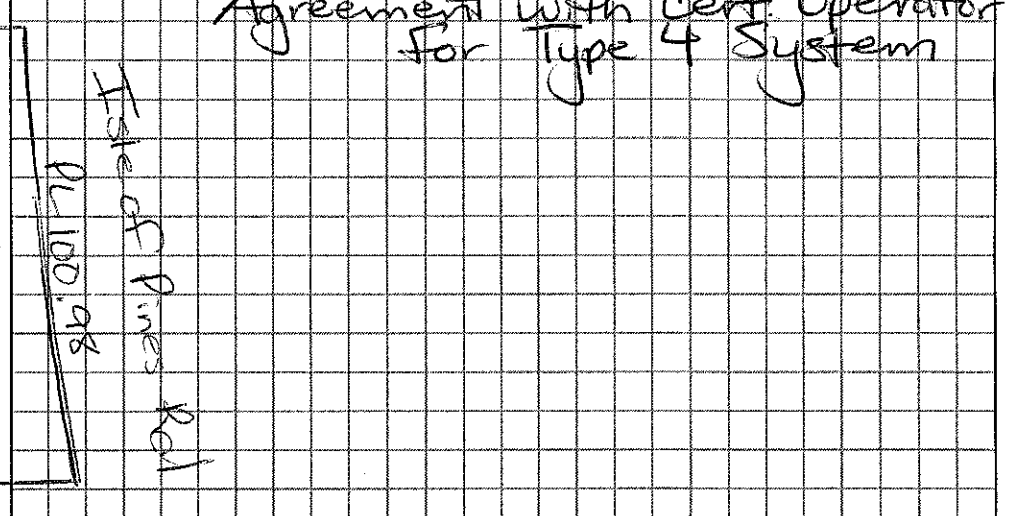

The proposed / existing 20'x12' Sunroom addition does not appear to impact the existing septic system.

**NOTE: Must keep any structure > 5ft from Septic System

Maintained Dotson R.S.

Date: 2/22/18

ICHD-Environmental Health Division

Permit can be suspended or revoked if any false information is supplied toward securing the permit / any unauthorized changes are made to the site / any unauthorized changes are made in the installation of the system.

☐ ***IMPROVEMENT PERMIT*** *with plat valid without expiration.* ☐ ***IMPROVEMENT PERMIT*** *with ~~plat valid without expiration.~~ site plan valid 60 mo* ☐ ***AUTHORIZATION TO CONSTRUCT*** valid for period equal to IMPROVEMENT PERMIT--not to exceed 60 mo.

Owner / Applicant Signature: David R Yountz Date

IMPROVEMENT PERMIT by: Maintained Dotson REHS Date 10/18/2011

AUTHORIZATION TO CONSTRUCT by: Maintained Dotson REHS Date 10/18/11

Installed by: David Yountz

OPERATION PERMIT by: Maintained Dotson REHS Date

Existing System Inspected by: REHS Date

YOU SHOULD CONTACT A LOCATOR SERVICE PRIOR TO ANY EXCAVATION

White Copy – Environmental Health YELLOW COPY (Final) Owner / Applicant PINK COPY (Initial) Owner / Applicant