IREDELL COUNTY HEALTH DEPARTMENT - *ENVIRONMENTAL HEALTH* ☐ STATESVILLE OFFICE 704-878-5305 ☐ MOORESVILLE OFFICE 704-664-5281

IMPROVEMENT PERMIT / AUTHORIZATION TO CONSTRUCT / OPERATION PERMIT / EXISTING SYSTEM INSPECTION

PERMIT # 163042 PIN # 4635298397 DATE 9-16-2011

OWNER Richard Farr APPLICANT: PHONE: Home/Cell # 704 360 2216 Business #

SITE ADDRESS ~~16~~ 104 Lake Hills M'ville NC OWNER / APPLICANT ADDRESS 163 Waterlynn Ridge Rd M'ville, NC

SITE DIRECTIONS Brawley School Rd TL Isle of Pines TL Lake Hills on Rt.

SUBDIVISION Lake hills East BLOCK / SECTION LOT # 14 LOT AREA .73Ac DESIGN FLOW 360gpd L.T.A.R. .3

Septic Tank 1000 Gallons: STB Date

Pump Tank Gallons: P T Date

Pump Make Model Serial #

No. Nitrification Fields: 1 No. Lines 4 Linear Feet 300

Trench Width 36" Max. Trench Bottom Depth 36" Gravel Depth N/A

☒ New System ☐ Repair ☐ Expansion System Type I II III IV V VI

System Description: Gravity - 25% Reduction

Repair System Description: Same

Maintenance Agreement Required ☐ YES ☐ NO

☒ GRAVITY ☐ PRESSURE

☒ Residence No. Bedrooms 3

☐ Business No. Persons

☐ Other No. Employees

☐ Slab ☐ Crawl Space


☐ Basement w/plumbing ☐ Basement w/o plumbing

Water Supply: ☒ Private ☐ Public ☐ Community


Comments / Conditions

Installed ADS 36, endFeed
No dist. box or drop boxes used

INITIAL SITE SKETCH

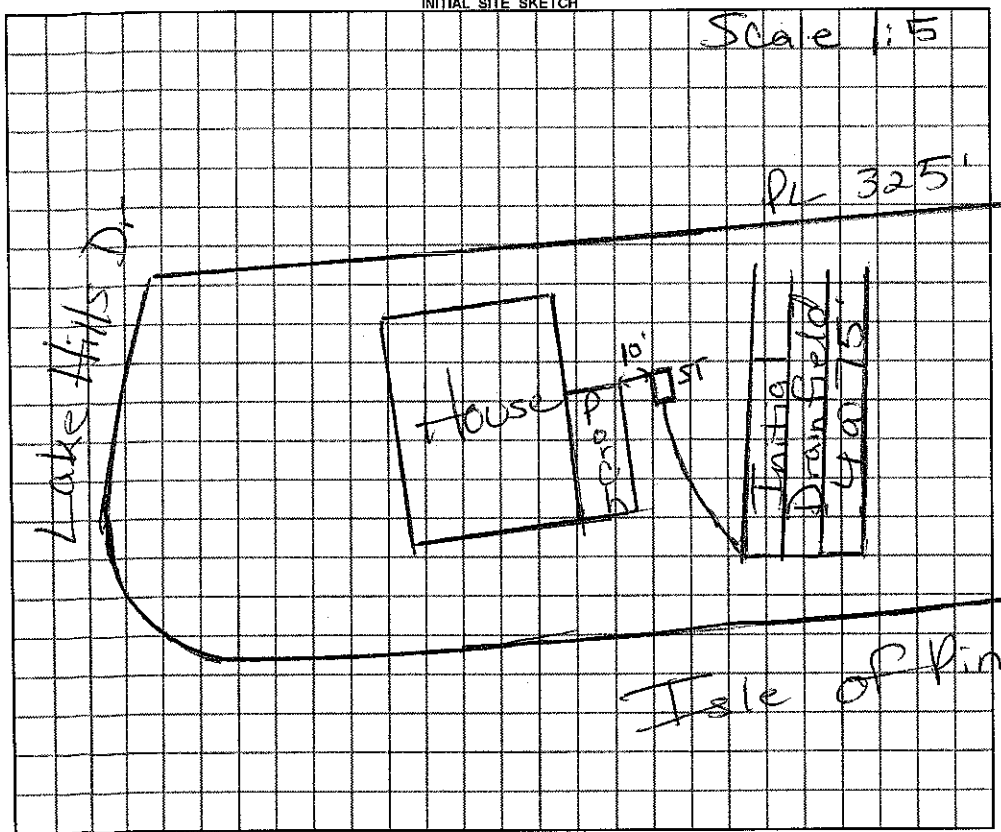

AS BUILT SKETCH

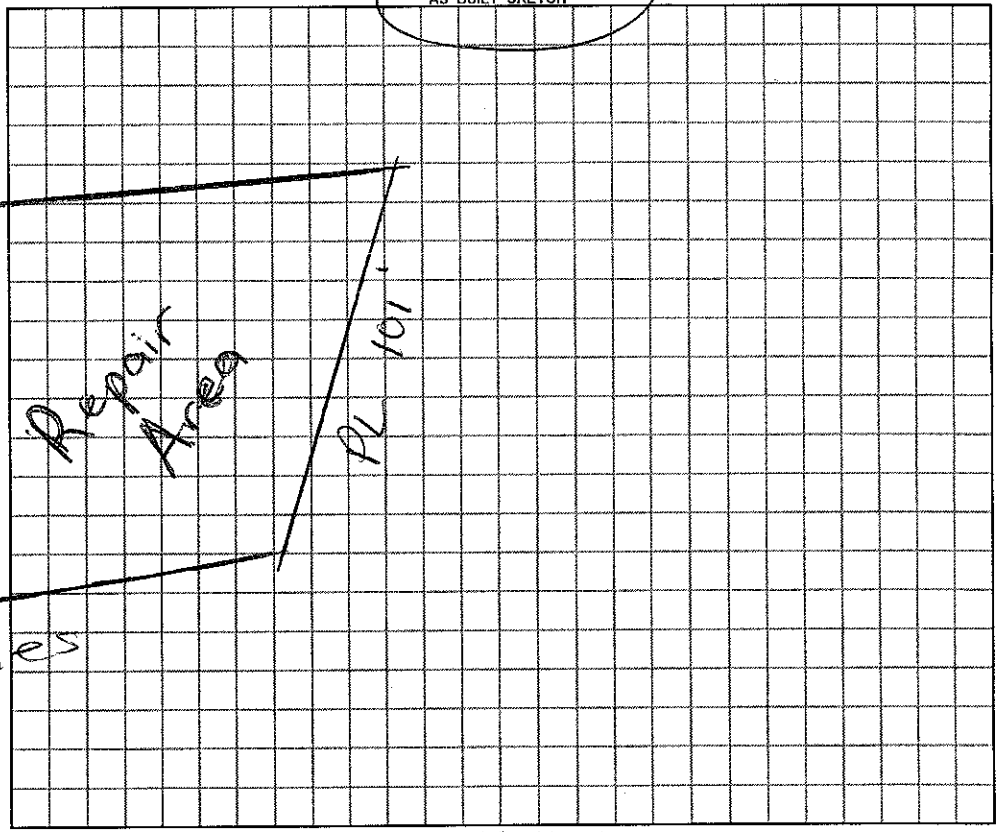

Permit can be suspended or revoked if any false information is supplied toward securing the permit / any unauthorized changes are made to the site / any unauthorized changes are made in the installation of the system.

☐ ***IMPROVEMENT PERMIT*** *with plat valid without expiration.* ☐ ***IMPROVEMENT PERMIT*** *with ~~plat valid without expiration.~~ site plan valid 60 mo.* ☐ ***AUTHORIZATION TO CONSTRUCT*** valid for period equal to IMPROVEMENT PERMIT--not to exceed 60 mo.

Owner / Applicant Signature: Date

IMPROVEMENT PERMIT by: REHS Date

AUTHORIZATION TO CONSTRUCT by: REHS Date

YOU SHOULD CONTACT A LOCATOR SERVICE PRIOR TO ANY EXCAVATION

Installed by: Charles Beatty

OPERATION PERMIT by: REHS Date 9/16/2011

Existing System Inspected by: REHS Date

White Copy – Environmental Health YELLOW COPY (Final) Owner / Applicant PINK COPY (Initial) Owner / Applicant

IREDELL COUNTY HEALTH DEPARTMENT

STATESVILLE 704-878-5305 MOORESVILLE 704-664-5281

IMPROVEMENT PERMIT / AUTHORIZATION TO CONSTRUCT / OPERATION PERMIT / EXISTING SYSTEM INSPECTION

PERMIT # 163042 PIN # 4635298397 DATE 9-17-2010

OWNER or APPLICANT Richard & Ann Farr PHONE: Business Cell 704 454-2292 Home: 704 360 2216

OWNER or APPLICANT ADDRESS 163 Waterlynn Ridge Rd Mooresville NC

LOCATION / DIRECTIONS Brawley School Rd TL Isle of Pines ~ 1 mile on left TL Lake Hill Dr on Rt.

SUBDIVISION Lakehills East. BLOCK / SECTION LOT # 14 LOT AREA 1.73Ac DESIGN FLOW 480gpd L.T.A.R. e3

Septic Tank 1000 Gallons: STB 1012 Date 11-23-11

Pump Tank Gallons: P T Date

Pump Make Model Serial #

Nitrification Field No Fields 1 No Lines 5 Linear Feet 460 300'

Trench Width 36" Max. Trench Bottom Depth 36" Gravel Depth N/A

☒ New System ☐ Repair ☐ Expansion System Type I II III IV V VI

System Description: Gravity - 25% Reduction

Repair System Description: Same

Maintenance Agreement Required ☐ YES ☒ NO

☒ GRAVITY ☐ PRESSURE

☒ Residence No. Bedrooms 4 3 ☐ Water Supply

☐ Business No. Persons ☒ Private

☐ Other No. Employees ☐ Public


☐ Slab ☒ Crawl Space ☐ Community

☐ Basement w/plumbing ☐ Basement w/o plumbing

Comments / Conditions Keep septic System at least 10ft from PL, minimum 50ft from any well


Note: If 3 Bedroom house built, then 300ft. of 25% Reduction Drainfield may be used.

INITIAL SITE SKETCH

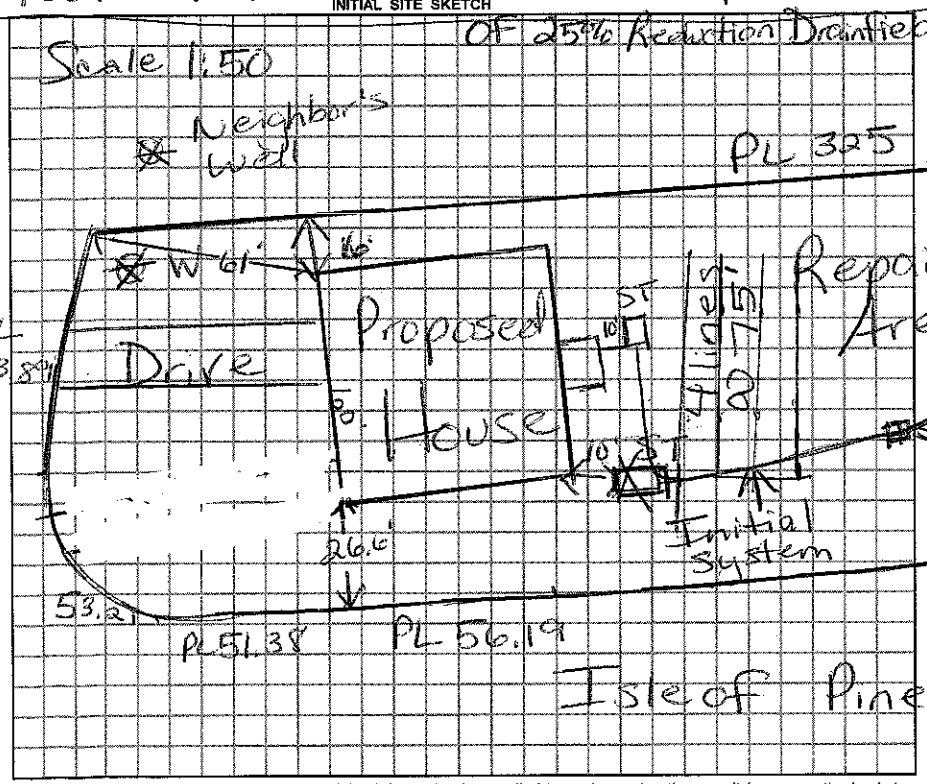

Comments / Conditions 1/3/2011 Reviewed Floor plan & is in Compliance with I.P. permit. Installed ADS 36 for Drainfield Ended, No Dist. box used.

AS BUILT SKETCH

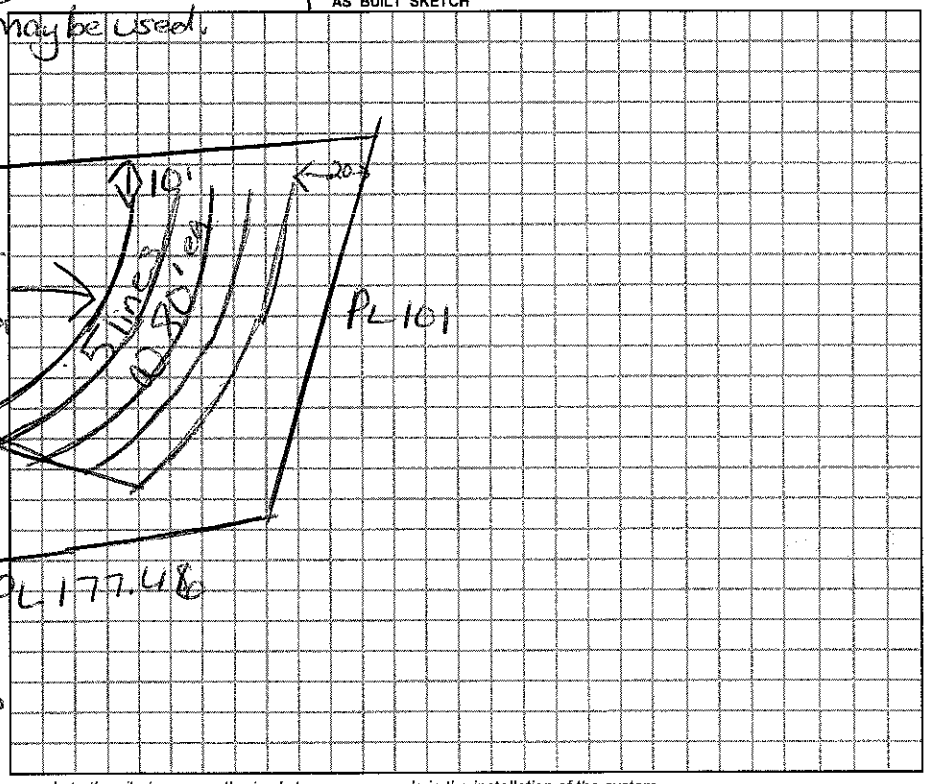

Permit can be suspended or revoked if any false information is supplied toward securing the permit / any unauthorized changes are made to the site / any unauthorized changes are made in the installation of the system.

☐ *IMPROVEMENT PERMIT w / plat valid without expiration.* ☐ *IMPROVEMENT PERMIT w / site plan valid for 60 mos.* ☐ *AUTHORIZATION TO CONSTRUCT valid for period equal to IMPROVEMENT PERMIT-not to exceed 60 mo.*

Owner / Applicant Signature: Richard C Farr Date 9/28/2010

Improvement Permit by: Maria H Thibeau REHS Date 9/17/2010

Authorzation to Construct by: Maria H Thibeau REHS Date 1/3/2011

Installed by: Charles Beatty RS Date: 9/15/2011

Operation Permit by: Maria H Thibeau Date:

Existing System Inspected by: Date:

YOU SHOULD CONTACT A LOCATOR SERVICE PRIOR TO ANY EXCAVATION.

WHITE COPY Environmental Health YELLOW COPY (Final) Owner / Applicant PINK COPY (Initial) Owner / Applicant