IREDELL COUNTY HEALTH DEPARTMENT

STATESVILLE 704-878-5305 MOORESVILLE 704-664-5281

$50 Paid 11.00

IMPROVEMENT PERMIT / AUTHORIZATION TO CONSTRUCT / OPERATION PERMIT / EXISTING SYSTEM INSPECTION

PERMIT# 101066 PIN# 4635-29-9964 DATE 11/19/02

OWNER OR CONTRACTOR Flagship Builders PHONE: Business (980) 721-1249 Home

ADDRESS 141 Angler Pl. Mooresville NC 28117

LOCATION Brawley Sch, TL Isle of Pines, on Lt past Cove Creek

SUBDIVISION Ivy Ridge BLOCK / SECTION LOT 6 LOT AREA SITE CLASS. PS DESIGN FLOW 360 L.T.A.R. 0.J

Septic Tank: 1000 Gallons; STB 312 Date 5-23-03

Pump Tank: Gallons; PT Date

Pump Make: Model Serial No.

Nitrification Field: No Fields 1 Square Feet 1200 Linear Feet 400'

No Lines 4 @ 5 Trench Width 36" Max Trench Bottom Depth 36" Gravel Depth 12"

[X] New System [ ] Repair System Type: I (II) III IV V VI

System Description: Gravity Conventional

Repair System Description: Same

Maintenance Agreement Required: [ ] Yes [X] No

[X] House/Mod. Home [ ] Mobile Home [ ] Business [ ] Other

No. Bedrooms 3 No. Bathrooms 2½ No. Employees


[ ] Slab [X] Crawl Space [ ] Basement w/plumbing [ ] Basement wo/plumbing

Water Supply: [X] Individual [ ] Public [ ] Community

Comments:/Conditions:

Comments:/Conditions: Blue filter installed & tank marker

1"=60' INITIAL SITE SKETCH

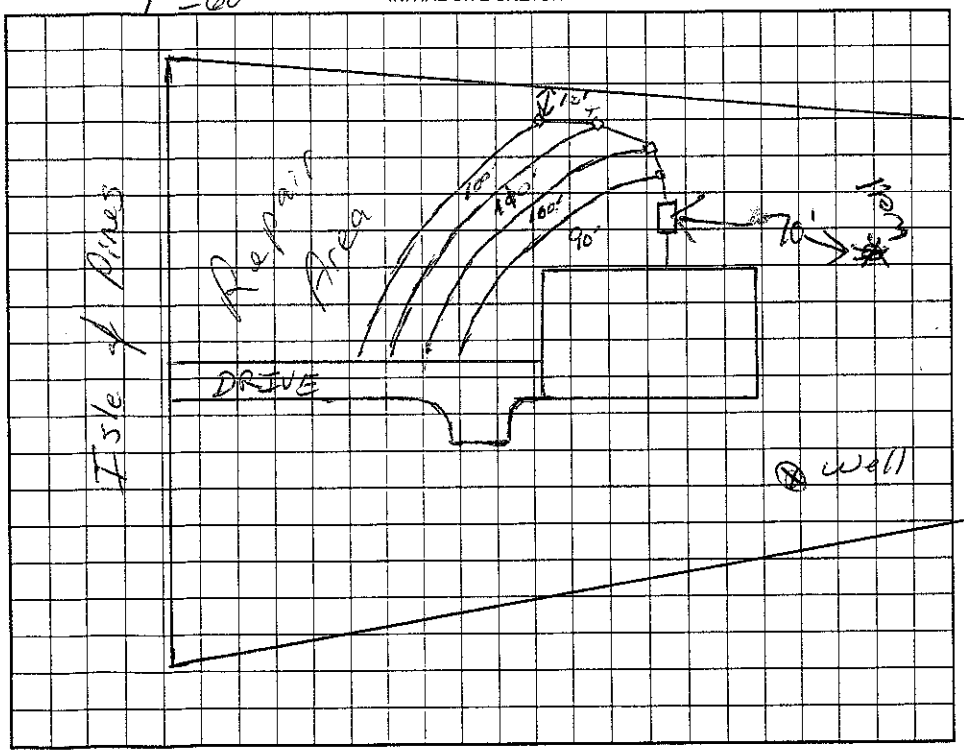

AS BUILT SKETCH

Installed as Drawn
Conventional System

Permit can be suspended or revoked if any false information is supplied toward securing the permit/any unauthorized changes are made to the site/any unauthorized changes are made in the installation of the system. Improvement Permit with plat valid without expiration. Improvement Permit with site plan valid for sixty months. Authorization to Construct is valid for a period equal to that of Improvement Permit – not to exceed sixty months.

Signed: Dwight Hanna date 12/2/02 Installed by: Richard Abernathy

Improvement Permit by: RS date 12/2/02 Operation Permit by: Maria H. Nelson RS title 7/1/03

Authorization to Construct by: RS date 12/2/02 Existing System Inspection by: date

HEALTH DEPT. COPY: WHITE OWNER COPY (FINAL): YELLOW OWNER COPY (INITIAL): PINK