IREDELL COUNTY HEALTH DEPARTMENT

Statesville Phone TR 3-7271 Mooresville Phone NO 3-1271

PERMIT TO INSTALL SEPTIC TANK

Permit No. _____ Permit Date 31 May 1966

Owner C. Marlowe Address Mt. Mourne,

Installed By Dawf. Osborne Address Mt. Mourne


Location of Property Isle of Pine Lot 24

Tank		Capacity		Length of Lines		Fixtures	
Block	( )	1000	(✓)	225'	(✓)	No. of Baths	( )
Precast	(✓)	1250	( )	250'	( )	Dishwasher	( )
		1500	( )	Other _____		Garbage Grdr.	( )
		Other _____				Other _____	

NOTIFY HEALTH DEPARTMENT AT LEAST EIGHT HOURS BEFORE TANK IS TO BE INSPECTED.

Final Inspection 31 May 1966 Approved (✓) Disapproved ( )

Remarks _____

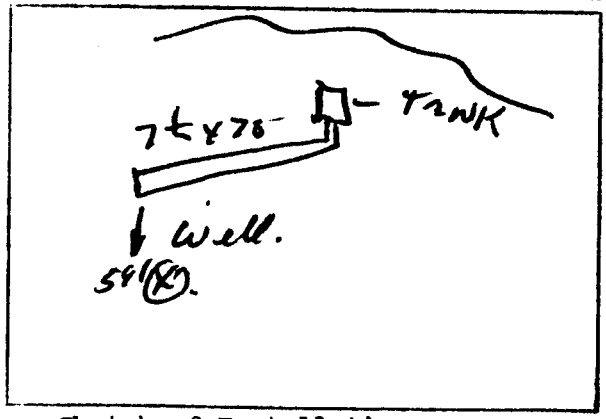

Sketch of Installation

Troy R. Simpson RS

Sanitarian