IREDELL COUNTY HEALTH DEPARTMENT - *ENVIRONMENTAL HEALTH* ☐ STATESVILLE OFFICE 704-878-5305 ☒ MOORESVILLE OFFICE 704-664-5281 cm

IMPROVEMENT PERMIT / AUTHORIZATION TO CONSTRUCT / OPERATION PERMIT / EXISTING SYSTEM INSPECTION

PERMIT # 167845 PIN # 4635-36-2932 DATE 8-8-11

OWNER Jim Morris APPLICANT: Deckscapes PHONE: Home/Cell # 704-587-9600 Business #

SITE ADDRESS 158 Sandy Shore Dr. OWNER / APPLICANT ADDRESS Same

SITE DIRECTIONS BSR, Isle of Pines, Ski Haven, Sandy Shore

SUBDIVISION Sureside Estates BLOCK / SECTION LOT # 8 LOT AREA 1.01 Ac DESIGN FLOW 360 L.T.A.R.

Septic Tank Gallons: STB Date

Pump Tank Gallons: PT Date

Pump Make Model EXISTING Serial #

No. Nitrification Fields: No. Lines Linear Feet

Trench Width Max. Trench Bottom Depth Gravel Depth

☐ New System ☐ Repair ☐ Expansion System Type I (i) III IV V VI

System Description: Gravel Bed

Repair System Description:

Maintenance Agreement Required ☐ YES ☒ NO

☒ GRAVITY ☐ PRESSURE

☒ Residence No. Bedrooms 3

☒ Business No. Persons

☐ Other No. Employees

☐ Slab ☐ Crawl Space

☐ Basement w/plumbing ☐ Basement w/o plumbing

Water Supply

☒ Private


☐ Public

☐ Community


Comments / Conditions (i) Deck must be Min 5' from Septic

Deck

INITIAL SITE SKETCH

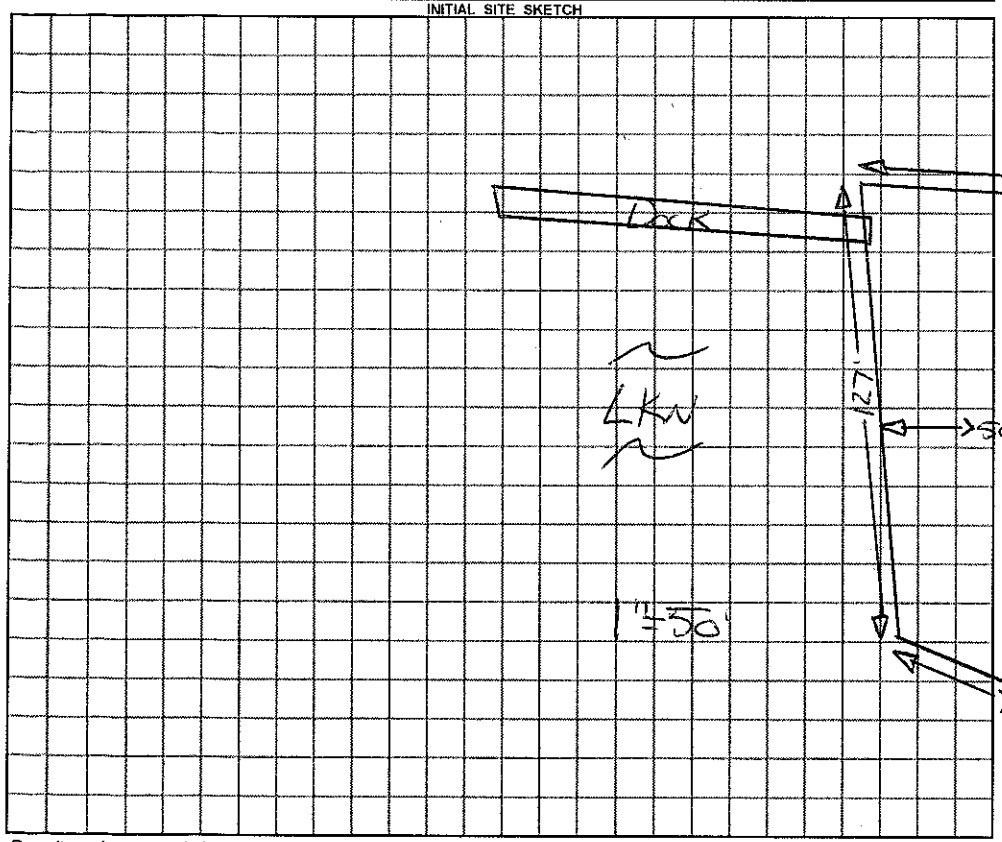

AS BUILT SKETCH

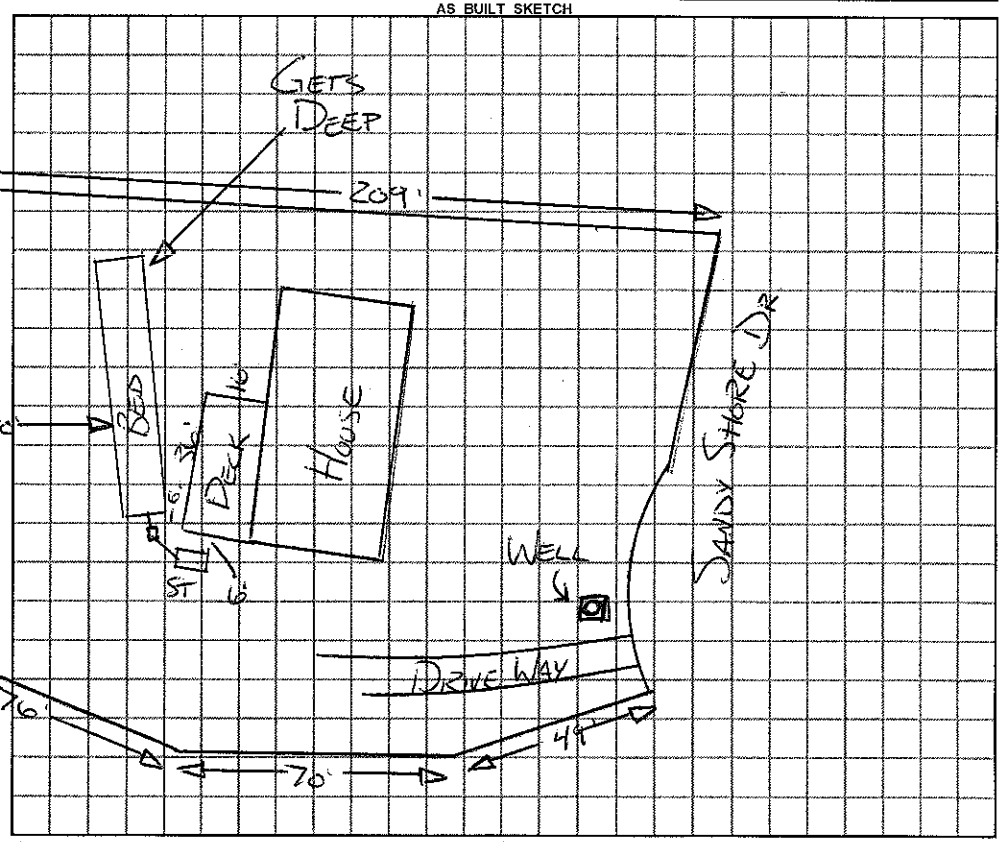

Permit can be suspended or revoked if any false information is supplied toward securing the permit / any unauthorized changes are made to the site / any unauthorized changes are made in the installation of the system.

☐ ***IMPROVEMENT PERMIT*** *with plat valid without expiration.* ☐ ***IMPROVEMENT PERMIT*** *with ~~plat valid without expiration.~~ site plan valid 60 mo.* ☐ ***AUTHORIZATION TO CONSTRUCT*** valid for period equal to IMPROVEMENT PERMIT–not to exceed 60 mo.

Owner / Applicant Signature: Sm Kesler Date 8/9/11 Installed by:

IMPROVEMENT PERMIT by: ***REHS*** Date OPERATION PERMIT by: ***REHS*** Date

AUTHORIZATION TO CONSTRUCT by: ***REHS*** Date Existing System Inspected by: B. A. Lee ***REHS*** Date 8-8-11

YOU SHOULD CONTACT A LOCATOR SERVICE PRIOR TO ANY EXCAVATION

White Copy – Environmental Health YELLOW COPY (Final) Owner / Applicant PINK COPY (Initial) Owner / Applicant