# IREDELL COUNTY HEALTH DEPARTMENT

STATESVILLE 704-878-5305 4635 36 3680 MOORESVILLE 704-664-5281

## IMPROVEMENT PERMIT / CERTIFICATE OF COMPLETION / OPERATION PERMIT / EXISTING SYSTEM INSPECTION

PROPERTY DESCRIPTION NO. 20516 DATE 3/28/95 TAX MAP NO. 2C / A 34 Watershed: ☐ Yes ☐ No

OWNER OR CONTRACTOR Edward Rosa PHONE: Business 704-543-4245 Home

ADDRESS 10427 Kilmory Terrace Charlotte, NC.

LOCATION Lake of Pines TR Beachview Ct. - straight at cul de sac

SUBDIVISION Lake of Pines BLOCK / SECTION LOT 34 LOT AREA 1.50 SITE CLASS. P DESIGN FLOW 360 L.T.A.R. .25

Septic Tank: 1000 Gallons; STB 794 Date 4/20/95

Pump Tank: 1000 Gallons; PT 27 Date 4/30/95

Pump Make: Model Serial No.

Nitrification Field: No Fields 1 Square Feet 1440 Linear Feet ~~X~~ 200

No Lines 4 Trench Width 24" Max Trench Bottom Depth 28"

☑ New System ☐ Repair System Type: I, II, III, IV, V, VI

System Description: Pressure Pond

Repair System Description:

Maintenance Agreement Required: ☑ Yes ☐ No

Gravel Depth 6" SAND ☐ Slab ☑ Crawl Space ☐ Basement w/plumbing ☐ Basement wo/plumbing

☑ House/Mod. Home No. Bedrooms 3

☐ Mobile Home No. Bathrooms 3

☐ Business No. Employees

☐ Other

Water Supply: ☑ Individual ☐ Community ☐ Public


Comments: 43 ~~HD~~ Panels - 3.6 gal per panel / Low 100 / Load 6" Gravel Lawn

Comments: 43 × 3.6 = 154 × .66 = 924 = 5" TRAVEL on float

258 + 129 = 387 924 + 924 = 1848 100 GPD.

1:40

INITIAL SITE SKETCH

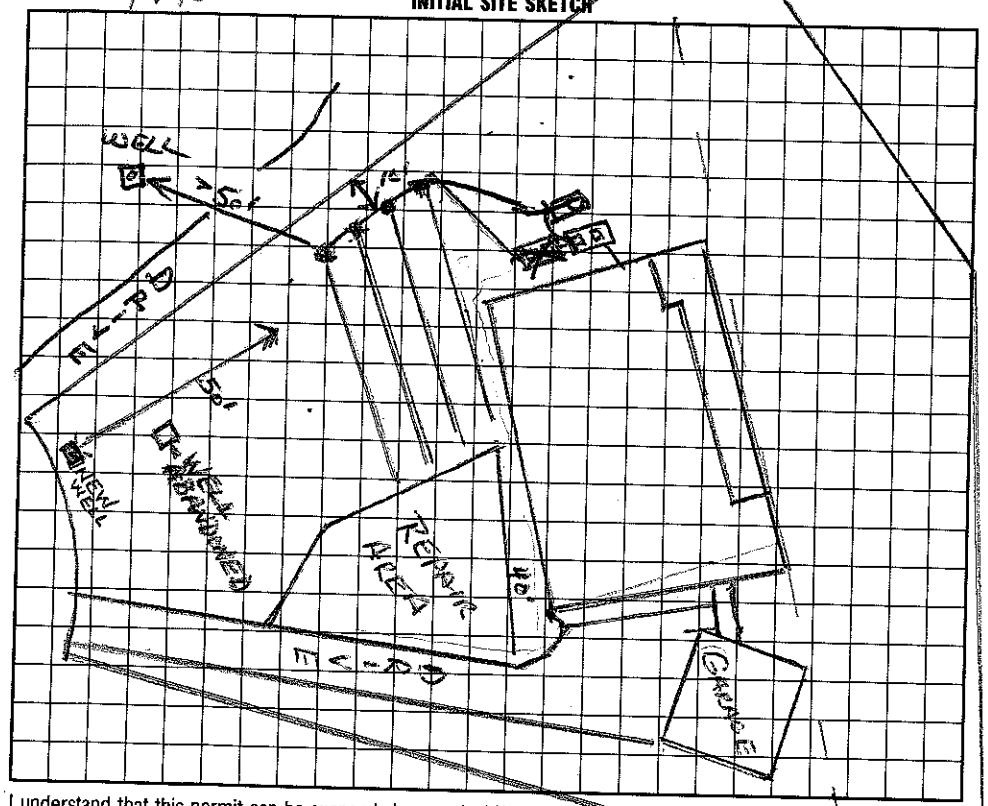


AS BUILT SKETCH

I understand that this permit can be suspended or revoked if any false information is supplied toward securing the permit/any unauthorized changes are made to the site/any unauthorized changes are made in the installation of the system. Improvement Permit is valid for 60 months from date of issuance.

Signed: Earl Ray Rosa

Improvement Permit by: Wesley Sparks RS date 3/28/95

Existing System Inspection by: date

Installed by: Tim Simmons

Certificate of Completion by: Wesley Sparks RS. date 6/27/95

Operation Permit by: Wesley Sparks RS. date 7/29/95

HEALTH DEPT. COPY: WHITE INSPECTION COPY (FINAL): GREEN OWNER COPY (FINAL): YELLOW INSPECTION COPY (INITIAL): PINK OWNER COPY (INITIAL): GOLD