Margaret Sharpe subdivision

IREDELL COUNTY HEALTH DEPARTMENT

STATESVILLE 704-878-5305 MOORESVILLE 704-664-5281

IMPROVEMENT PERMIT / AUTHORIZATION TO CONSTRUCT / OPERATION PERMIT / EXISTING SYSTEM INSPECTION

PERMIT# 074451 PIN# 4639368898 4635-36-9815 Dave DATE 5/21/03

OWNER OR CONTRACTOR Drew Beringer / Whitehouse Builders PHONE: Business 309-4301 Home

ADDRESS 118 N. Shore Dr. Mooresville, NC 28117

LOCATION Brawley School Rd TL Isle of Pines on left past Ruby Rd

SUBDIVISION Clay BLOCK / SECTION 5 LOT 34 LOT AREA 1.67 Acre SITE CLASS PS DESIGN FLOW 600gpd L.T.A.R. .3

Septic Tank 1500 Gallons: STB 338 Date 9-16-03
Pump Tank 1500 Gallons: PT 338 Date 9-1-03
Pump Make: Model Serial No.
Nitrification Field: No Fields 1 Square Feet 1512 Linear Feet 504
No Lines 6@84' Trench Width 36" Max Trench Bottom Depth 36" Gravel Depth N/A

[X] New System [ ] Repair System Type: I, II, III, IV, V, VI
System Description: Pump-PM-25% Reduction
Repair System Description: Same
Maintenance Agreement Required: [ ] Yes [X] No

[X] House/Mod. Home No. Bedrooms 5
[ ] Mobile Home No. Bathrooms 5
[ ] Business No. Employees
[ ] Other


Water Supply: [X] Individual [ ] Public [ ] Community

[ ] Slab [X] Crawl Space [ ] Basement w/plumbing [ ] Basement wo/plumbing

Comments:/Conditions: Keep Septic System at least 10' from PL, 50' from lake & 100' from well. Note: Soil in tank pit looked like CL until close to bottom of pit.


Comments:/Conditions: Note: Keep Drainlines 15' from driveway cut.
[X] Must "properly abandon" old well prior to Septic System installation.

INITIAL SITE SKETCH Scale 1:60

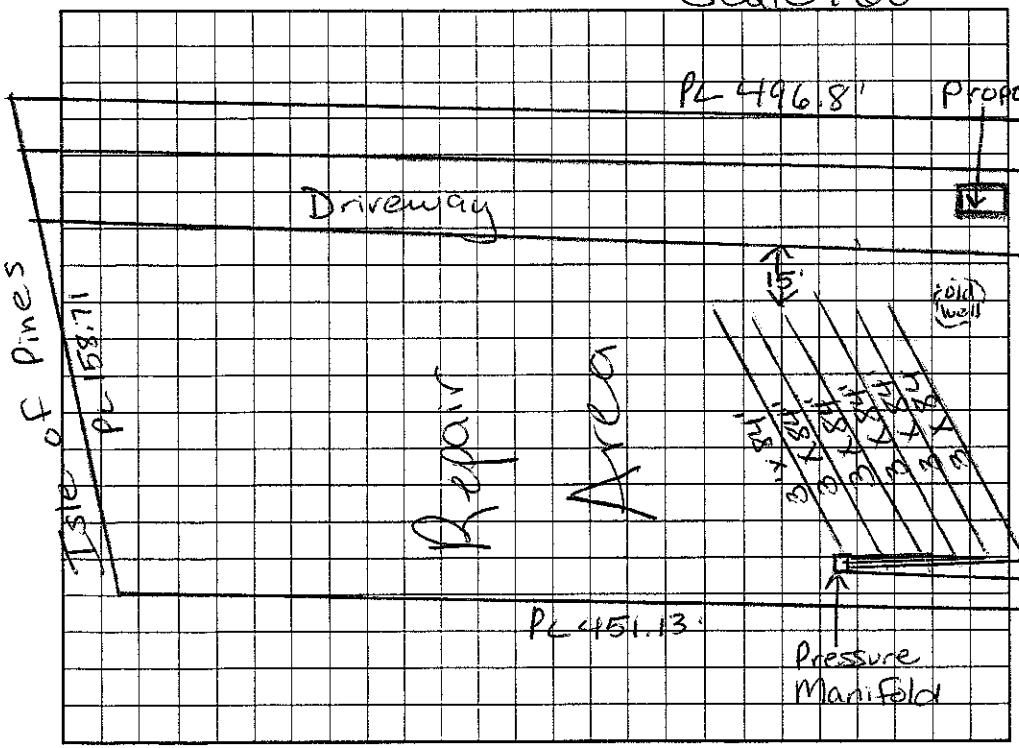

AS BUILT SKETCH

Installed 7 +70' lines of EZ Flow

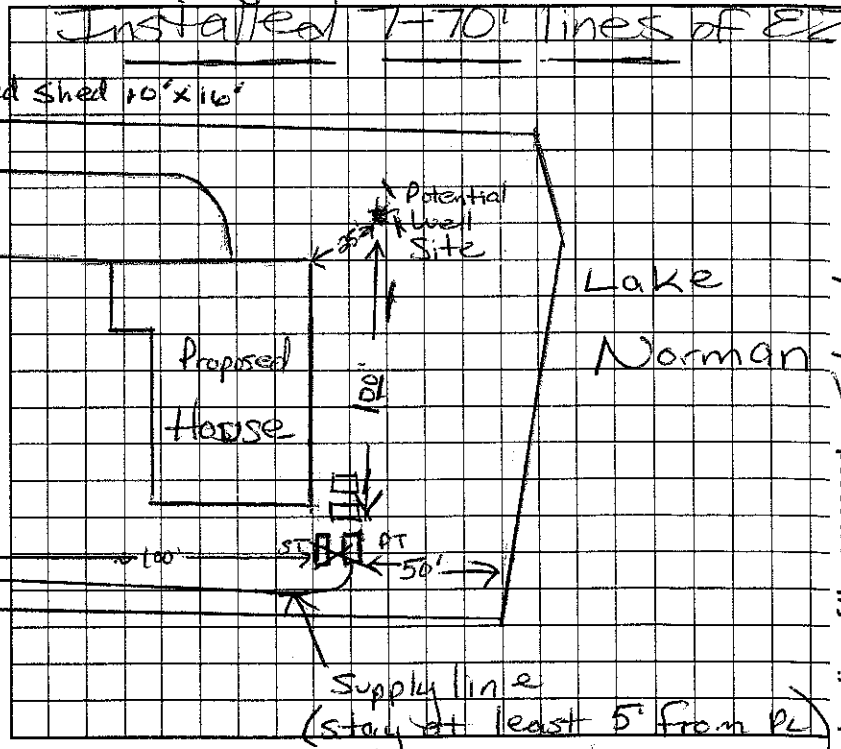

The location of the proposed Shed addition does not appear to impact the existing septic system.

**NOTE: Date: 4-7-11 REHS
ICHD-Environmental Health Division

Permit can be suspended or revoked if any false information is supplied toward securing the permit/any unauthorized changes are made to the site/any unauthorized changes are made in the installation of the syster
Permit with plat valid without expiration. Improvement Permit with site plan valid for sixty months. Authorization to Construct is valid for a period equal to that of Improvement Permit – not to exceed sixty months.

Signed: X [signature] date 5/22/03 Installed by: R&H

Improvement Permit by: Maria H Dotson RS date 5/21/03 Operation Permit by: Maria H Dotson RS date 1/7/04

Authorization to Construct by: Maria H Dotson RS date 5/21/03 Existing System Inspection by: date

HEALTH DEPT. COPY: WHITE OWNER COPY (FINAL): YELLOW OWNER COPY (INITIAL): PINK