IREDELL COUNTY HEALTH DEPARTMENT

Statesville Office (704) 878-5305 DSE Mooresville Office (704) 660-3625 PERMIT # 209584

IMPROVEMENT PERMIT / AUTHORIZATION TO CONSTRUCT / OPERATION PERMIT / EXISTING SYSTEM

PIN # 4655-36-9827

APPLICANT: KELLY Custom Builders APPLICANT ADDRESS: Po Box 3276 Mooresville

SITE ADDRESS: 567 Isle of Pines PHONE: 704-987-7755 ALT. PHONE:

SITE DIRECTIONS: BSR, TL Isle of Pines, on L

SUBDIVISION: MARGARET L. SHARPE SECTION: LOT # 2 LOT AREA: 1.586 AC DESIGN FLOW: 600 L.T.A.R.: .3

SETTLING Tank 1500 (gal) STB Date

SEPTIC Tank 1500 (gal) PT Date

Pump Make Model Serial #

Nitrification Fields 1 # Lines 1 @ 100' Linear Ft: 100'

Trench Width 36" Max. Trench Bottom Depth 30" Gravel Depth

☐ New System ☐ Repair ☒ Expansion System Type: I II III IV V VI

System Description: CONVENTIONAL + 25% RED

Repair System Description: 25% REDUCTION

Maintenance Agreement Required: ☐ YES ☒ NO

☒ GRAVITY ☐ PRESSURE

☐ Residence ☐ Business ☒ Other ☐ Slab ☐ Basement w/plumbing

No. Bedrooms 5 No. Persons No. Employees ☐ Crawl Space

Water Supply: ☒ Private ☐ Public ☐ Community

☐ Basement w/o plumbing

Comments / Conditions:

CONVERTING Ex. Room TO BEDROOM

OUT DOOR KITCHEN

INITIAL SITE SKETCH

SEE PLAN FROM TONY JACOBS

AS BUILT SKETCH

CHECKED DRAIN LINES & TANKS BA

CHECKED DBox BA

8-14-15

Permit can be suspended or revoked if any false information is supplied toward securing the permit / any unauthorized changes are made to the site / any unauthorized changes are made in the installation of the system. **CONTACT A LOCATOR SERVICE PRIOR TO ANY EXCAVATION**

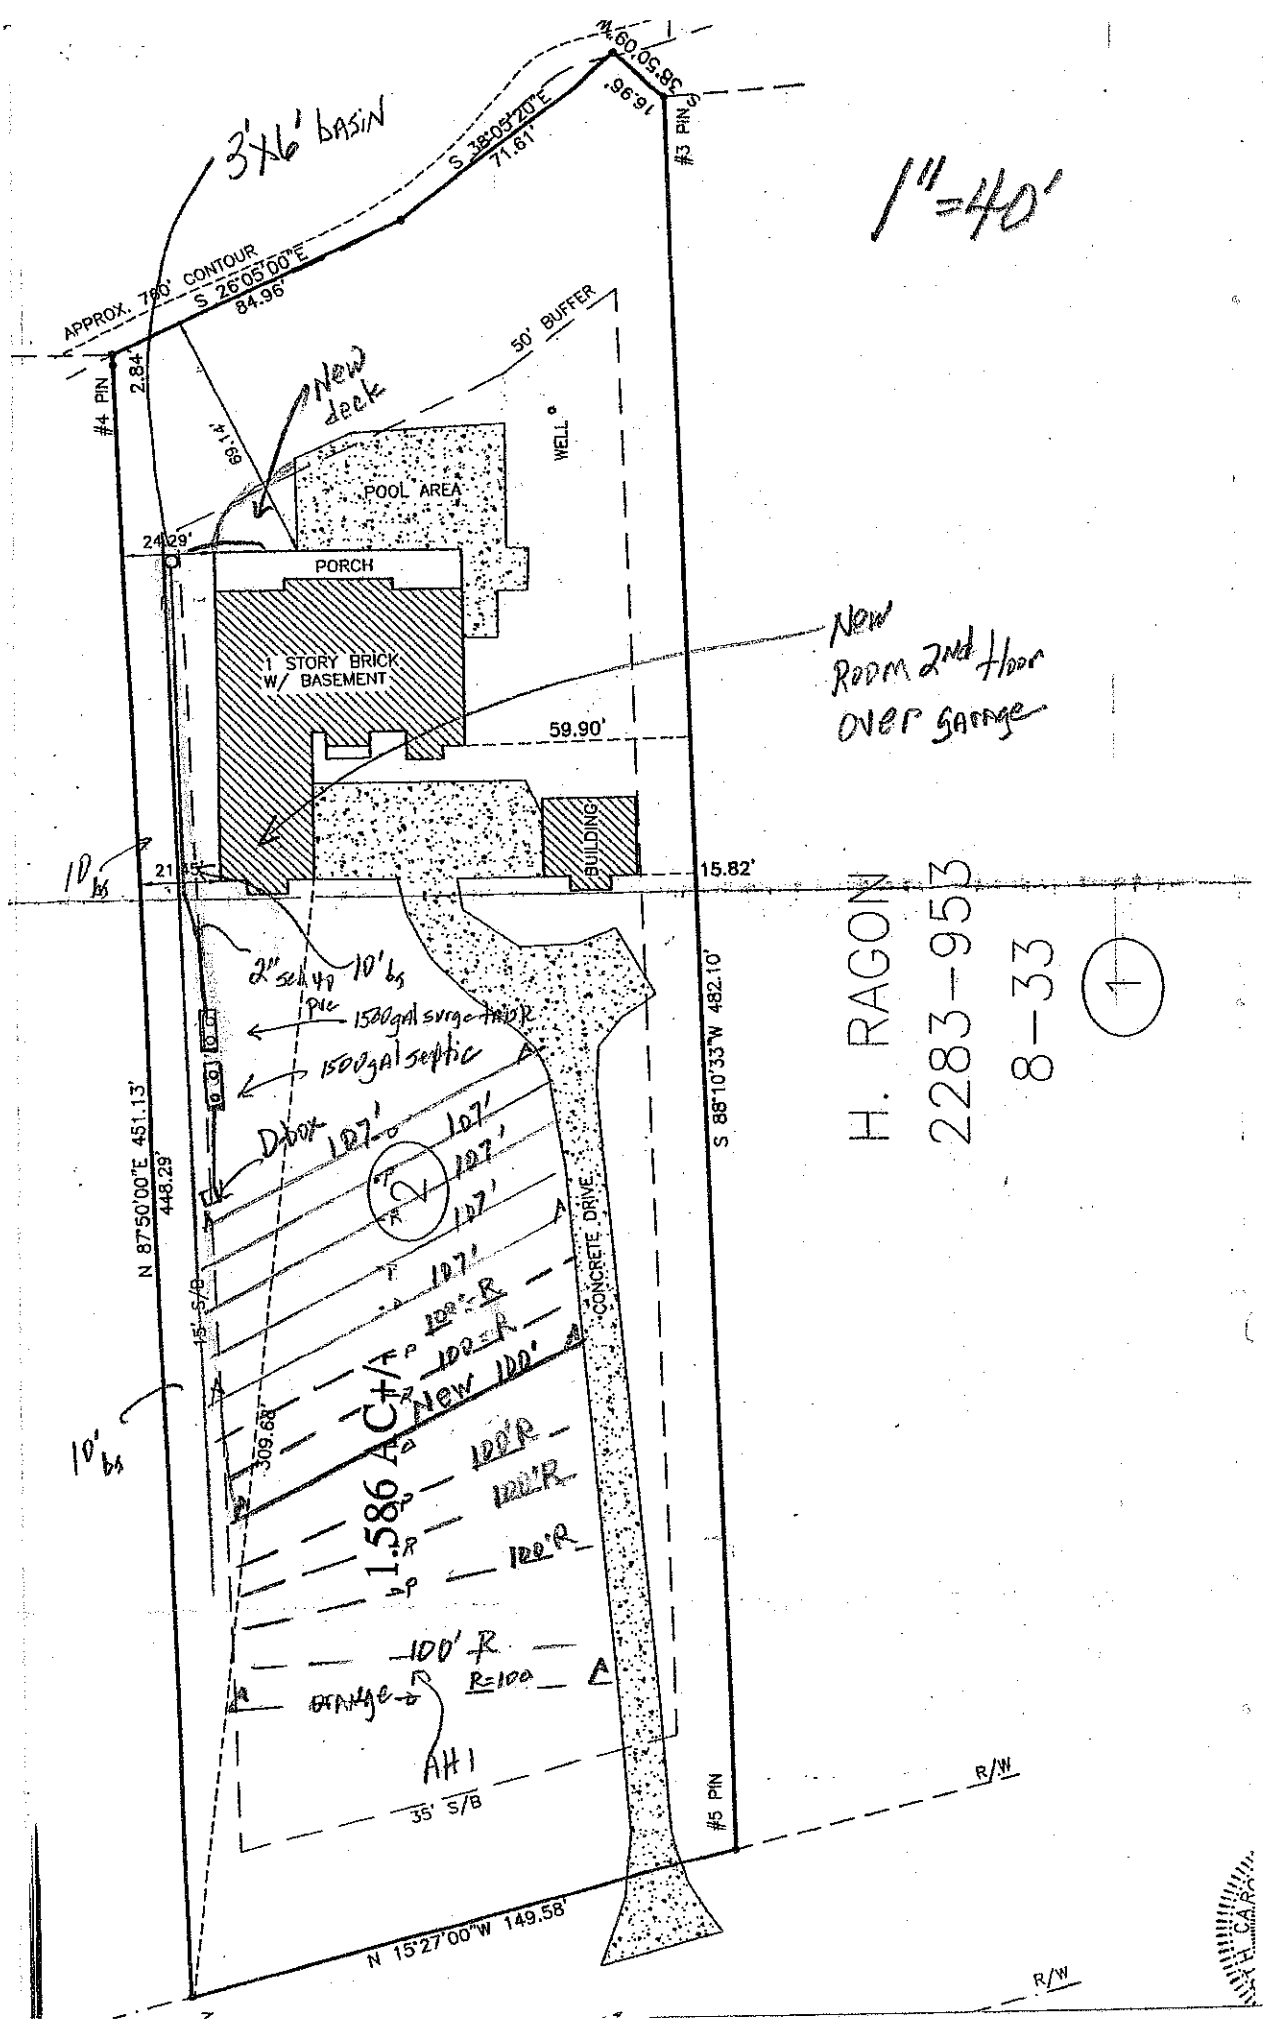
☐ **IMPROVEMENT PERMIT** *with plat valid without expiration.* ☒ **IMPROVEMENT PERMIT** *with site plan valid for 60 mos.* ☒ **AUTHORIZATION TO CONSTRUCT** *valid for period equal to IMPROVEMENT PERMIT--not to exceed 60 mo.*

Owner / Applicant Signature: Date: 5-6-15 Installed by: STEVE JORDAN

IMPROVEMENT PERMIT by: APPROVED Date: MAY 05 2015 OPERATION PERMIT by: Date: 8-14-15

AUTHORIZATION TO CONSTRUCT by: Date: 5-6-15 Existing System Inspected by: Date:

Health Dept. Copy - WHITE Applicant (Final Approval) - YELLOW Applicant (Conditional Approval) - PINK


3'x6' BASIN
1"=40'
APPROX. 780' CONTOUR
S 26°05'00"E
84.96'
S 38°05'20"E
71.61'
N 60°50'38"E
16.96'
#3 PIN
#4 PIN
2.84'
69.14'
New deck
50' BUFFER
WELL
POOL AREA
24.29'
PORCH
1 STORY BRICK W/ BASEMENT
New Room 2nd Floor over garage
59.90'
BUILDING
15.82'
10' bs
21.5'
2" sch 40 PVC
10' bs
1500gal surge tnk
1500gal septic
D'box
10.0'
10.0'
107'
107'
107'
107'
107'
100'R
102'R
New 100'
CONCRETE DRIVE
S 88°10'33"W 482.10'
N 87°50'00"E 451.13'
448.29'
15' S/B
309.68'
10' bs
1.586 AC+/-
100'R
100'R
120'R
100' R
R=100
orange
AH1
35' S/B
#5 PIN
R/W
N 15°27'00"W 149.58'
R/W
H. RAGON
2283-953
8-33
1