Margaret Sharpe

IREDELL COUNTY HEALTH DEPARTMENT

STATESVILLE 704-878-5305

IMPROVEMENT PERMIT / AUTHORIZATION TO CONSTRUCT / OPERATION PERMIT / EXISTING SYSTEM INSPECTION

Lot 77 [redacted]

PERMIT# 073976 PIN# 4635368898 4635-36-9827 DATE 1-31-2003

OWNER OR CONTRACTOR Earl Ray Hiatt PHONE: Business 872-5014 Home 506-6140

ADDRESS 165 Yacht Cove Ln Mooresville NC 28117

LOCATION Brawley School Rd. TL Isle of Pines near end on left (84 Beachview Rd)

SUBDIVISION Isle of Pines BLOCK / SECTION 5 LOT 35 LOT AREA SITE CLASS PS DESIGN FLOW 480gpd L.T.A.R. .3

Septic Tank: 1000 Gallons; STB 794 Date 3/16/03
Pump Tank: 1000 Gallons; PT 27 Date 2/28/03
Pump Make: MYERS Model ME 50-521 Serial No. 11/02
Nitrification Field: No Fields 1 Square Feet 1605 Linear Feet 535'
No Lines 5@107' Trench Width 36" Max Trench Bottom Depth 36" Gravel Depth 12"

☒ New System ☐ Repair System Type: I, II, (III), IV, V, VI
System Description: Pump-(PM) Conventional
Repair System Description: Pump-Innovative
Maintenance Agreement Required: ☐ Yes ☒ No


☒ House/Mod. Home ☐ Mobile Home ☐ Business ☐ Other
No. Bedrooms 4 No. Bathrooms 4 No. Employees
☐ Slab ☐ Crawl Space ☒ Basement w/plumbing ☐ Basement wo/plumbing

Water Supply: ☒ Individual ☐ Public ☐ Community


Comments:/Conditions: Keep Septic System at least 10' From PL, 50' From Lake & 50-100' From any Well.

Comments:/Conditions: Note to installer: If you can not install 107' on line closest to house then use flow divider & use extra line.

Scale 1:60 INITIAL SITE SKETCH

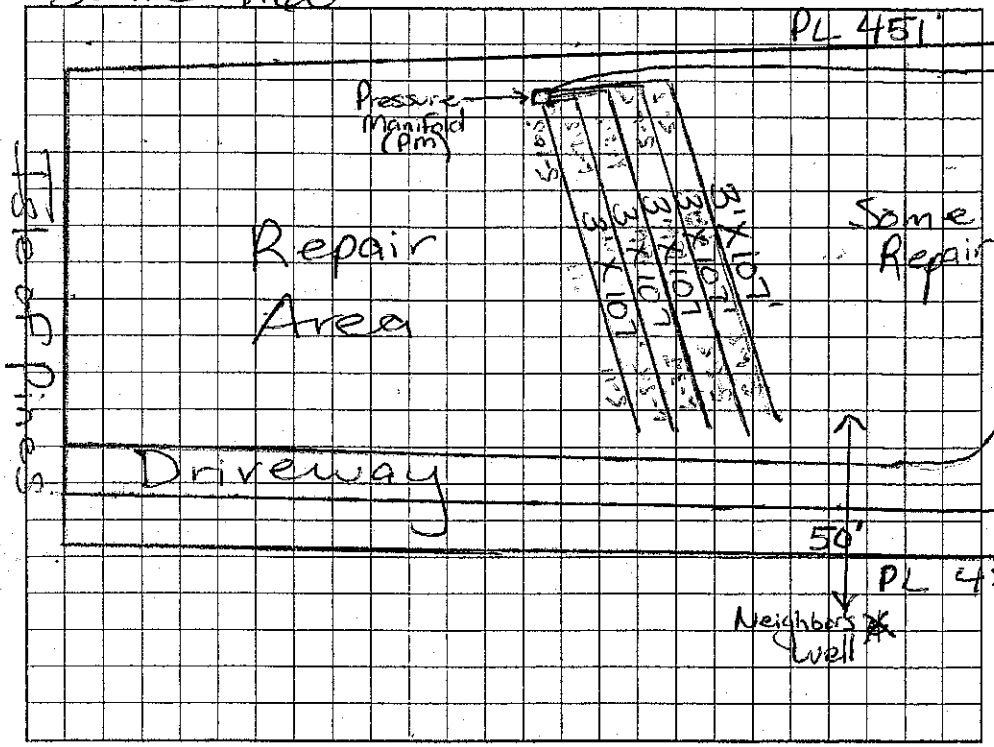

AS BUILT SKETCH

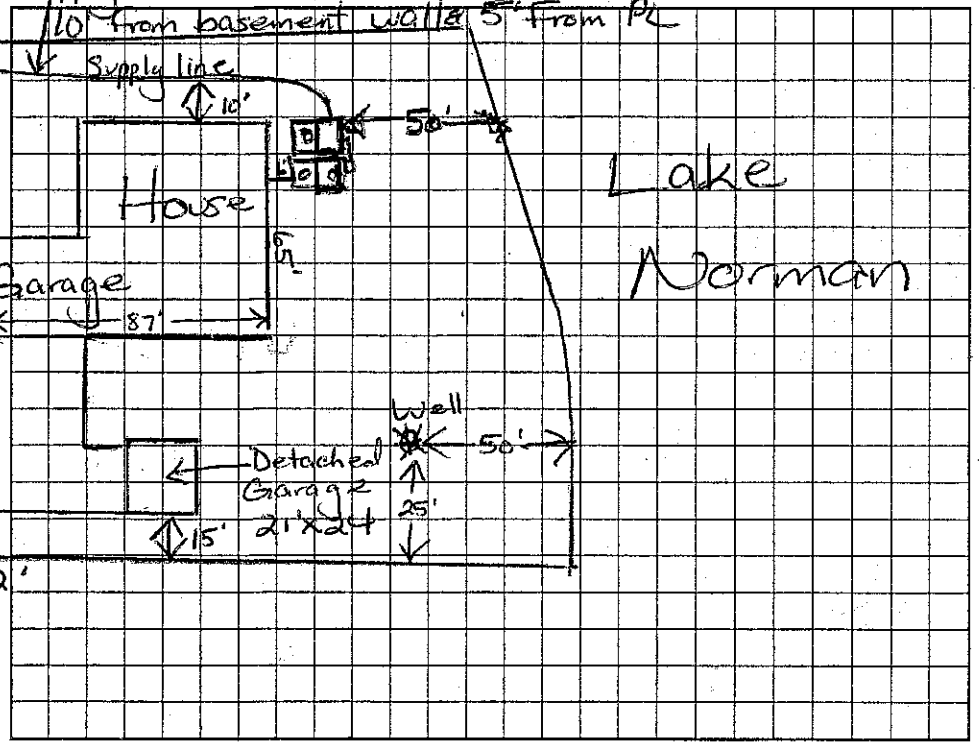

Permit can be suspended or revoked if any false information is supplied toward securing the permit/any unauthorized changes are made to the site/any unauthorized changes are made in the installation of the system. Improvement Permit with plat valid without expiration. Improvement Permit with site plan valid for sixty months. Authorization to Construct is valid for a period equal to that of Improvement Permit – not to exceed sixty months.

Signed: Earl Ray Hiatt date

Improvement Permit by: Maria H. Dotson RS date 1/31/03

Authorization to Construct by: Maria H. Dotson RS date 1/31/03

Installed by: Tim Brannon

Operation Permit by: Wesley Sparks RS date 6/17/03

Existing System Inspection by: date

HEALTH DEPT. COPY: WHITE OWNER COPY (FINAL): YELLOW OWNER COPY (INITIAL): PINK