IREDELL COUNTY HEALTH DEPARTMENT


ENVIRONMENTAL HEALTH DIVISION

PAGE 2: *SITE PLAN WORKSHEET*

SEE THE "SAMPLE SITE PLAN" BELOW. *INCOMPLETE SITE PLANS WILL BE RETURNED TO YOU FOR COMPLETION AND MAY RESULT IN A DELAY IN THE ISSUANCE OF YOUR SEPTIC SYSTEM PERMIT!!!*

Place an (X) beside each item as you complete the site plan:

- ( ) **Property Line measurements are clearly identified**
- ( ) **All proposed structures are indicated**
- ( ) **Front and side setbacks from property line**
- ( ) **Preferred driveway location and well location**
- ( ) **Area you prefer your septic system to be placed**
- ( ) **North arrow, or other sufficient indicator of direction**

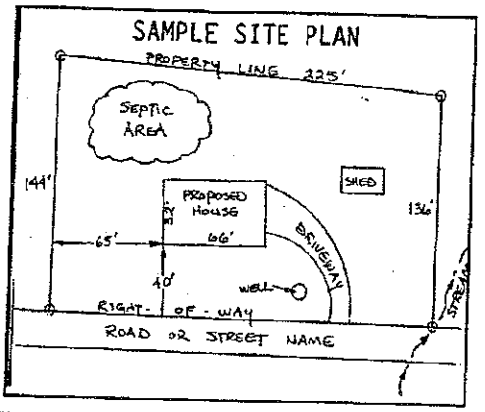

Circle N/A on the following if appropriate:

Location of septic systems and wells within 100' of your property	**N/A**
Location of easements and rights of ways on your property	**N/A**
Location of any designated wetlands on the property	**N/A**

USE THIS SPACE TO DRAW YOUR SITE PLAN

Show: proposed house or business footprint, wells, water lines, patios, pools and decks, and any other item that will occupy space on the site

See Attached

Signature: Lisa Avery

Property owner or owner's legal representative signature (SIGNATURE REQUIRED)

4/9/2015

DATE

567 Isle of Pines

Lot 2

9827

Lot 27

IREDELL COUNTY HEALTH DEPARTMENT

STATESVILLE 704-878-5305 — MOORESVILLE 704-664-5281

IMPROVEMENT PERMIT / AUTHORIZATION TO CONSTRUCT / OPERATION PERMIT / EXISTING SYSTEM INSPECTION

PERMIT# 073976 PIN# 4635368898 4635-36-[illegible] DATE 1-31-2003

OWNER OR CONTRACTOR Earl Ray Hiatt PHONE: Business 512-5501 Home 596-6140

ADDRESS 165 Yacht Cove Ln Mooresville NC 28115

LOCATION Brawley School Rd. to Isle of Pines near end on left (1st Beachview)

SUBDIVISION Lot 5 BLOCK / SECTION [illegible] LOT 35 LOT AREA SITE CLASS: PS DESIGN FLOW 480 gpd L.T.A.R. .3

Margaret L. Sharpe

Septic Tank: 1000 Gallons: STB 794 Date 2/10/03

Pump Tank: 1000 Gallons: PT [illegible] Date 2/28/03

Pump Make: Myers Model ME 50M-521 Serial No. 11027

Nitrification Field: No Fields 1 Square Feet 1602 Linear Feet 535

No Lines 5 @ 107' Trench Width 36" Max Trench Bottom Depth 36" Gravel Depth 12"

☒ New System ☐ Repair System Type: I, II, III, IV, V, VI

System Description: Pump – (Pm) Conventional

Repair System Description: Pump – Innovative

Maintenance Agreement Required: ☐ Yes ☒ No

☒ House/Mod. Home ☐ Mobile Home ☐ Business ☐ Other

No. Bedrooms 4 No. Bathrooms 4 No. Employees


Water Supply: ☒ Individual ☐ Public ☐ Community

☐ Slab ☐ Crawl Space ☒ Basement w/plumbing ☐ Basement w/o plumbing


Comments/Conditions: Keep Septic System at least 10' from PL, 50' from lake & 50-100 from any well.

Comments/Conditions: Note to installer: If you can not install 107' on line closest to house then use flow divider & use extra line.

Scale 1:60 INITIAL SITE SKETCH

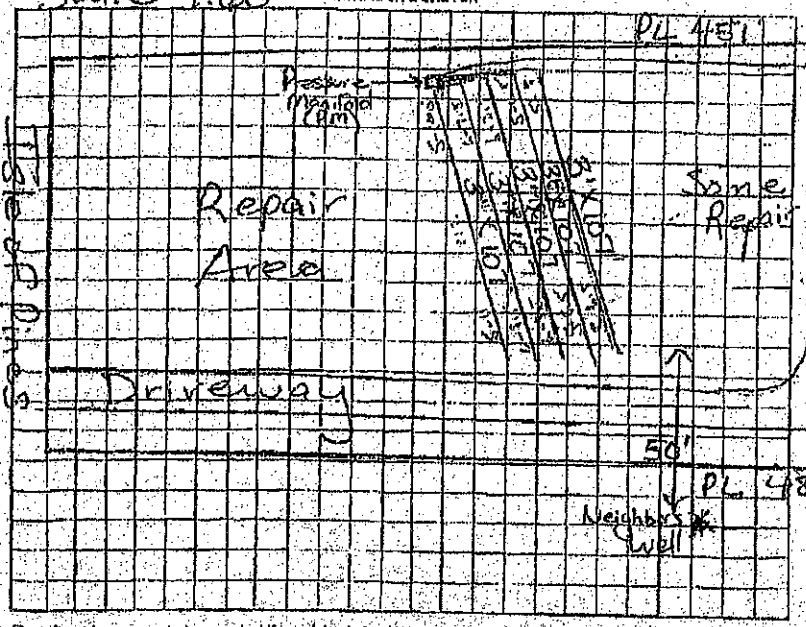

AS BUILT SKETCH

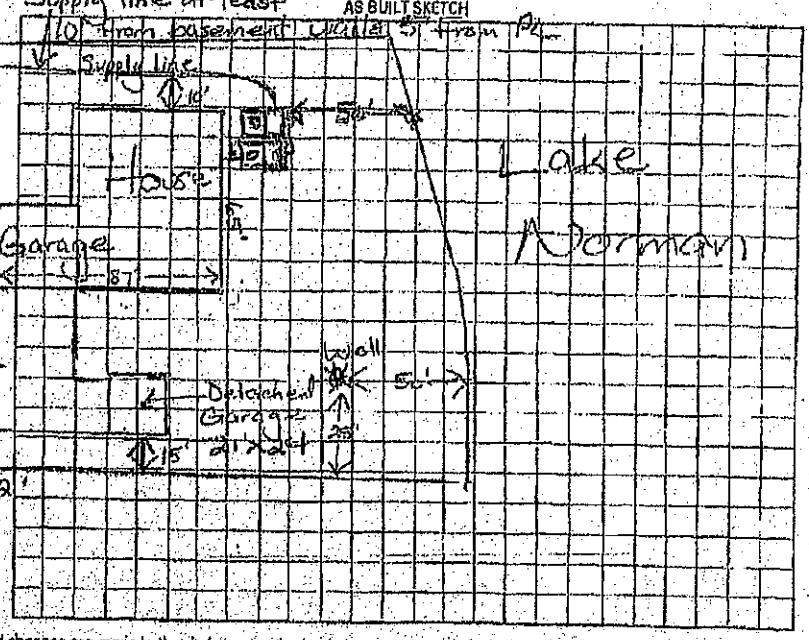

Permit can be suspended or revoked if any false information is supplied toward securing the permit/any unauthorized changes are made to the site/any unauthorized changes are made in the installation of the system. Improvement Permit with plat valid without expiration. Improvement Permit with site plan valid for sixty months. Authorization to Construct is valid for a period equal to that of Improvement Permit – not to exceed sixty months.

Signed: [signature] date

Improvement Permit by: [signature] RS date 1/31/03

Authorization to Construct by: [signature] RS date 2/21/03

Installed by: [signature]

Operation Permit by: [signature] RS date 6/17/03

Existing System Inspection by: [signature] date

HEALTH DEPT. COPY: WHITE OWNER COPY (FINAL): YELLOW OWNER COPY (INITIAL): PINK

p.5

Sep 22 15 09:11p