(4+5) 9.30-9.75

IREDELL COUNTY HEALTH DEPARTMENT

STATESVILLE 704-878-5305 MOORESVILLE 704-664-5281

IMPROVEMENT PERMIT / CERTIFICATE OF COMPLETION / OPERATION PERMIT / EXISTING SYSTEM INSPECTION

PROPERTY DESCRIPTION NO. 066670 DATE 5/29/97 TAX MAP NO. 4635 37378 2378 Watershed: ☑ Yes ☐ No

OWNER OR CONTRACTOR BENJAMIN MEREDITH PHONE: Business _____ Home 662-8309

ADDRESS 108 HARBORVIEW PL MOORESVILLE

LOCATION ISLE OF PINES - TR HARBORVIEW - 2ND HOUSE ON RT

SUBDIVISION SURFSIDE BLOCK / SECTION _____ LOT 36 LOT AREA _____ SITE CLASS. PS DESIGN FLOW 360GPD L.T.A.R. _____

Septic Tank: 1000 Gallons: STB _____ Date _____

Pump Tank: EXISTING Gallons: PT _____ Date _____

Pump Make: _____ Model _____ Serial No. _____

Nitrification Field: No Fields ____ Square Feet _____ Linear Feet _____

No Lines _____ Trench Width _____ Max Trench Bottom Depth _____ Gravel Depth _____

☑ New System ☐ Repair System Type: I, II, III, IV, V, VI

System Description: CONVENTIONAL

Repair System Description: _____

Maintenance Agreement Required: ☐ Yes ☐ No

☑ House/Mod. Home No. Bedrooms 3

☐ Mobile Home No. Bathrooms 3

☐ Business No. Employees ____

☐ Other _____


☐ Slab ☑ Crawl Space ☐ Basement w/plumbing ☐ Basement wo/plumbing

Water Supply: ☑ Individual ☐ Community ☐ Public

Comments: TIE INTO OLD SYSTEM. GRINDER PUMP SET.

Comments: SUPPLY LINE CHECKED

INITIAL SITE SKETCH

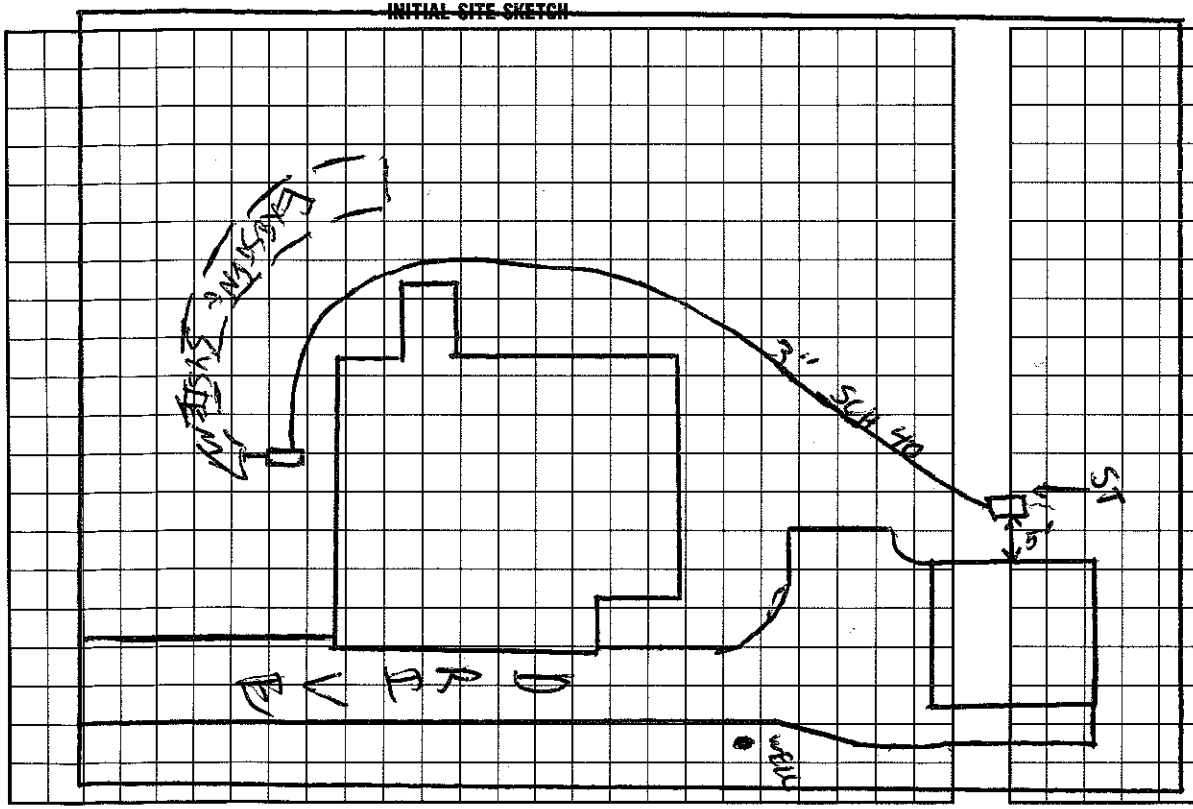

AS BUILT SKETCH

I understand that this permit can be suspended or revoked if any false information is supplied toward securing the permit/any unauthorized changes are made to the site/any unauthorized changes are made in the installation of the system. Improvement Permit is valid for 60 months from date of issuance.

Signed: Ben Meredith

Installed by: BEN MEREDITH

Improvement Permit by: C. Ray Keen date 5/29/97

Certificate of Completion by: _____ date _____

Existing System Inspection by: C. Ray Keen date 5/29/97

Operation Permit by: C. Ray Keen date 4/6/98

HEALTH DEPT. COPY: WHITE INSPECTION COPY (FINAL): GREEN OWNER COPY (FINAL): YELLOW INSPECTION COPY (INITIAL): PINK OWNER COPY (INITIAL): GOLD