IREDELL COUNTY HEALTH DEPARTMENT

STATESVILLE 704-878-5305 MOORESVILLE 704-664-5281

IMPROVEMENT PERMIT / AUTHORIZATION TO CONSTRUCT / OPERATION PERMIT / EXISTING SYSTEM INSPECTION

3,20

PERMIT# 105838 PIN# 4635-37-2663 DATE 5/21/02

OWNER OR CONTRACTOR Charles Cooke / BILLY HALE PHONE: Business Home 704-523-3902

ADDRESS 111 Watford Ct. Charlotte, NC. 28210

LOCATION 1100 Th side of Pines on (R) past Vista Pl. intersection, corner lot.

SUBDIVISION Sunfield Estates BLOCK SECTION LOT 33 LOT AREA .47 SITE CLASS PS DESIGN FLOW 360 L.T.A.R. .3

Septic Tank: 1000 Gallons; STB 794 Date 11/2/03

Pump Tank: 1000 Gallons; PT 283 Date 6/17/03

Pump Make: Little Giant Model Serial No.

Nitrification Field: No Fields 1 Square Feet 900 * Linear Feet 300 *

No Lines 4@75' Trench Width 3' Max Trench Bottom Depth 3' Gravel Depth No

☐ New System ☐ Repair System Type: I, II, (III) IV, V, VI

System Description: Pres Man - EZ Lay or Chamber

Repair System Description: 16" APBRS - Pressure Dosed

Maintenance Agreement Required: ☐ Yes ☒ No

☒ House/Mod. Home No. Bedrooms 3

☐ Mobile Home No. Bathrooms 3

☐ Business No. Employees

☐ Other


☐ Slab ☒ Crawl Space ☐ Basement w/plumbing ☐ Basement wo/plumbing

Water Supply: ☒ Individual ☐ Public ☐ Community

Comments/Conditions: * This is a 25% reduction system
* Note 100' set back from all wells

Comments/Conditions: Inspection waived

(1" = 40') INITIAL SITE SKETCH

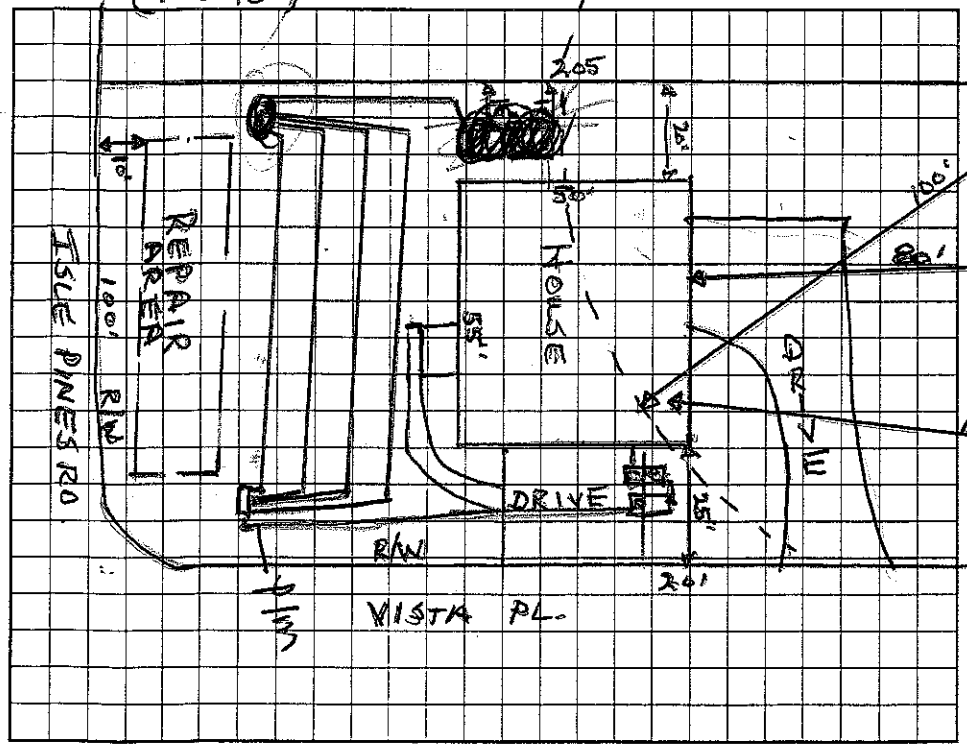

AS BUILT SKETCH

Permit can be suspended or revoked if any false information is supplied toward securing the permit/any unauthorized changes are made to the site/any unauthorized changes are made in the installation of the system. Improvement Permit with plat valid without expiration. Improvement Permit with site plan valid for sixty months. Authorization to Construct is valid for a period equal to that of Improvement Permit – not to exceed sixty months.

Signed: * Charles Cooke date 6/3/02 Installed by: Richard Abernathy

Improvement Permit by: Wesley Sparks RS. date 5/21/02 Operation Permit by: Wesley Sparks RS. date 8/27/04

Authorization to Construct by: CG RS date 7/23/03 Existing System Inspection by: date

HEALTH DEPT. COPY: WHITE OWNER COPY (FINAL): YELLOW OWNER COPY (INITIAL): PINK