1.30

IREDELL COUNTY HEALTH DEPARTMENT

STATESVILLE 704-878-5305 MOORESVILLE 704-664-5281

IMPROVEMENT PERMIT / AUTHORIZATION TO CONSTRUCT / OPERATION PERMIT / EXISTING SYSTEM INSPECTION

PERMIT# 078945 PIN# 4635374134 DATE 2/10/99

OWNER OR CONTRACTOR DON WIMBESH PHONE: Business _____ Home _____

ADDRESS 119 PENTLAND CT MOORESVILLE - NC 28115

LOCATION BRAWLEY SCHOOL TL ISLE OF PINES. 2nd ON RT PAST HARBOR VIEW

SUBDIVISION SURFSIDE BLOCK / SECTION _____ LOT 4 LOT AREA .45AC SITE CLASS. PS DESIGN FLOW 360GPD L.T.A.R. .3000/FT

Septic Tank: 1000 Gallons; STB 825 Date 4/1/99
Pump Tank: _____ Gallons; PT _____ Date _____
Pump Make: _____ Model _____ Serial No. _____
Nitrification Field: No Fields 1 Square Feet 900 Linear Feet 300
No Lines 4@75' Trench Width 36" Max Trench Bottom Depth 36" Gravel Depth N/A

☑ New System ☐ Repair System Type: I, II, III, IV, V, VI
System Description: GRAVITY CHAMBERS HDS
Repair System Description: PANEL
Maintenance Agreement Required: ☐ Yes ☑ No


☑ House/Mod. Home No. Bedrooms 3
☐ Mobile Home No. Bathrooms 2
☐ Business No. Employees ____
☐ Other _____
☐ Slab ☑ Crawl Space ☐ Basement w/plumbing ☐ Basement wo/plumbing

Water Supply: ☑ Individual ☐ Public ☐ Community

Comments:/Conditions: KEEP SYSTEM 50+ FROM NEIGHBOR'S WELL

Comments:/Conditions:

1"=40' INITIAL SITE SKETCH

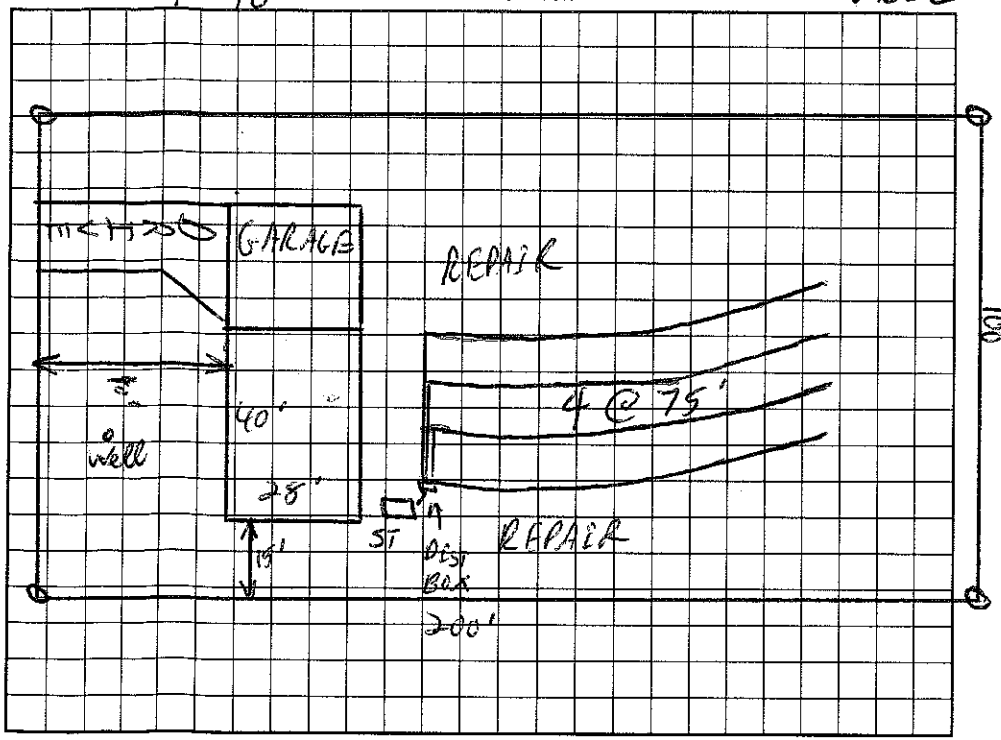

AS BUILT SKETCH

Permit can be suspended or revoked if any false information is supplied toward securing the permit/any unauthorized changes are made to the site/any unauthorized changes are made in the installation of the system. Improvement Permit with plat valid without expiration. Improvement Permit with site plan valid for sixty months. Authorization to Construct is valid for a period equal to that of Improvement Permit – not to exceed sixty months.

Signed: _____ date 2-12-99 Installed by: WAYNE CLONTZ

Improvement Permit by: C. Hyatt RS date 2/10/99 Operation Permit by: C. Hyatt RS date 5/12/99

Authorization to Construct by: C. Hyatt RS date 2/16/99 Existing System Inspection by: _____ date _____

HEALTH DEPT. COPY: WHITE OWNER COPY (FINAL): YELLOW OWNER COPY (INITIAL): PINK