IREDELL COUNTY HEALTH DEPARTMENT

STATESVILLE 704-878-5305 MOORESVILLE 704-664-5281

IMPROVEMENT PERMIT / AUTHORIZATION TO CONSTRUCT / OPERATION PERMIT / EXISTING SYSTEM INSPECTION

PERMIT# 129875 PIN# 4635379105 DATE 3/29/06

OWNER OR APPLICANT Patrick Joseph & Assoc. PHONE: Business 746 6497 Home 791-8448 Van

ADDRESS 15415 Jetton Rd Cornelius, NC 28031

LOCATION Brawley School Rd TL Isle of Pines Property on left across from Harborview Place.

SUBDIVISION The Reserve @ Isle of Pines BLOCK / SECTION ____ LOT 2 LOT AREA .80 Acre SITE CLASS. PS DESIGN FLOW 480gpd L.T.A.R. .3

Septic Tank: 1000 Gallons; STB 3871 Date 3/13/06

Pump Tank: 1000 Gallons; PT 40 Date 3/7/06

Pump Make: MYERS Model ME-40 Serial No. ____

Nitrification Field: No Fields 1 Square Feet 536' Linear Feet 268'

No Lines 4 @ 67' Trench Width ~~24~~ See Note Max Trench Bottom Depth 36" Gravel Depth N/A ☐ Gravity ☒ Pressure

☒ New System ☐ Repair ☐ Expansion System Type: I, II, III, IV, V, VI

System Description: Pump-LP-Panel Block

Repair System Description: Same

Maintenance Agreement Required: ☐ Yes ☐ No

☒ House/Mod. Home ☐ Mobile Home ☐ Business ☐ Other

No. Bedrooms 4 No. Persons ____ No. Employees ____


Water Supply: ☐ Individual ☒ Public ☒ Community

☐ Slab ☒ Crawl Space ☐ Basement w/plumbing ☐ Basement wo/plumbing


Comments:/Conditions: ~~A~~ Use trench width as specified in original plan by Rollans Environmental ~~X~~ Use In line filter in Pump tank Builder using Grinder or Sewage lift pump at lower side.

Comments:/Conditions: Use "T" on inlet pipe into Septic tank & in line filter in PT.

INITIAL SITE SKETCH Scale 1:60

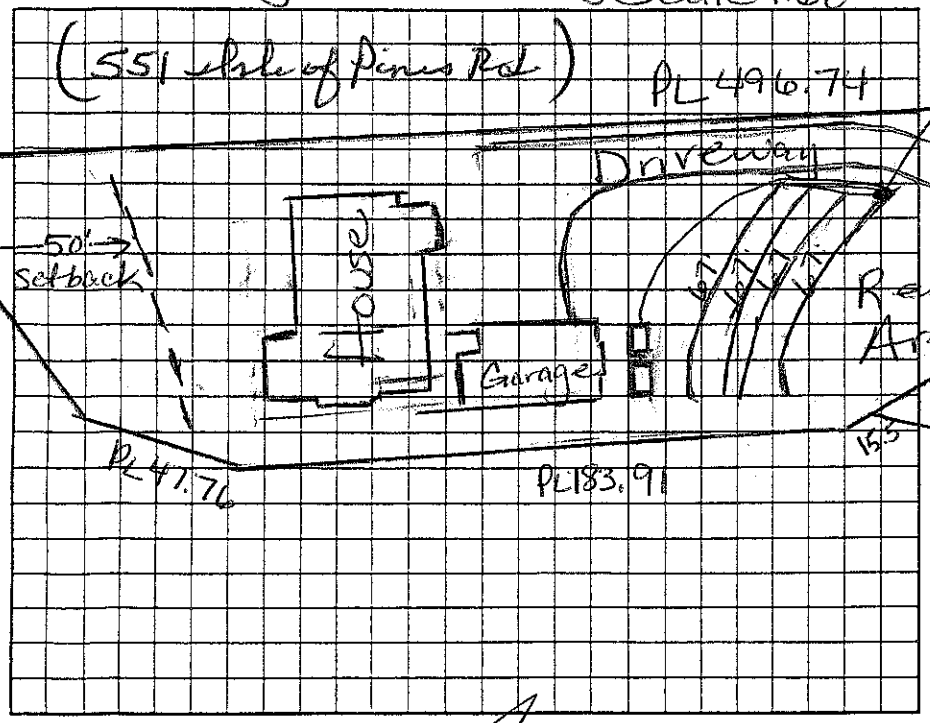

AS BUILT SKETCH

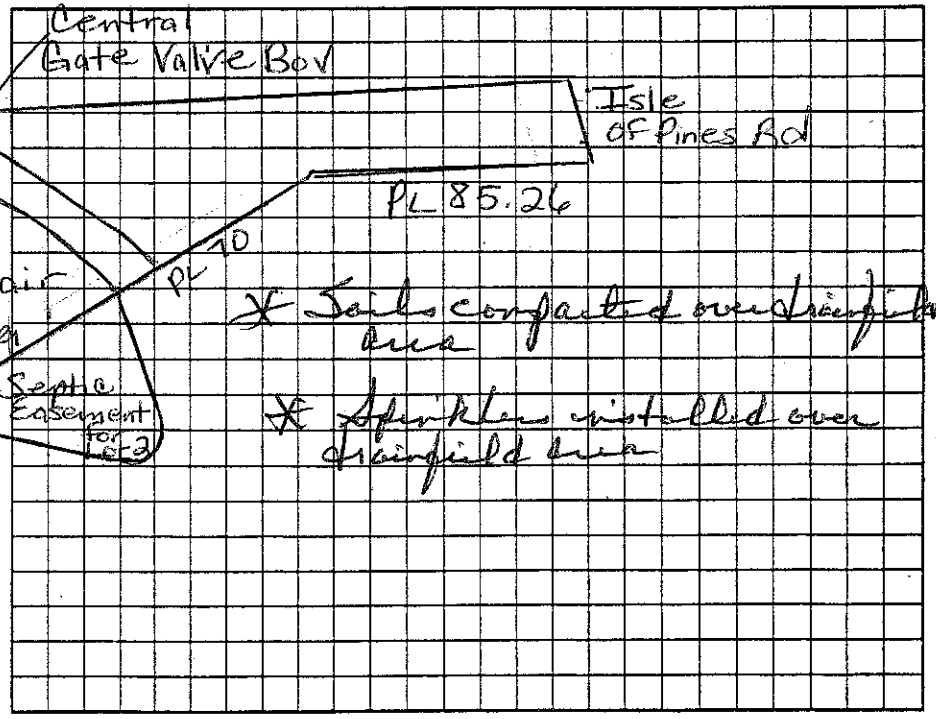

Permit can be suspended or revoked if any false information is supplied toward securing the permit/any unauthorized changes are made to the site/any unauthorized changes are made in the installation of the system. Improvement Permit with plat valid without expiration ☐ Improvement Permit with site plan valid for sixty months ☐ Authorization to Construct is valid for a period equal to that of Improvement Permit – not to exceed sixty months.

Signed: ____ date 3.03.06 Installed by: Benji Septic Tank

Improvement Permit by: Maria H. Dotson RS date 3/29/06 Operation Permit by: Wesley Sparkman RS date 8/4/06

Authorization to Construct by: Maria H. Dotson RS date 3/29/06 Existing System Inspection by: ____ date ____

HEALTH DEPT. COPY: WHITE OWNER COPY (FINAL): YELLOW OWNER COPY (INITIAL): PINK

Wayne Norman