IREDELL COUNTY HEALTH DEPARTMENT

STATESVILLE 704-878-5305 / 130.0 MOORESVILLE 704-664-5281

IMPROVEMENT PERMIT / AUTHORIZATION TO CONSTRUCT / OPERATION PERMIT / EXISTING SYSTEM INSPECTION

PERMIT# 123841 PIN# 4635 38 0263 DATE 10/15/04

OWNER OR CONTRACTOR Michael Lance Ryan PHONE: Business 704-361-1084 Home

ADDRESS 215 Capital Circle Ave Mooresville, NC. 28115

LOCATION 1100 TL Isle of Pines, TR Ski Haven, Corner lot on (R)

SUBDIVISION Sunside Est. BLOCK SECTION LOT 27 LOT AREA .42 Ac SITE CLASS. PS DESIGN FLOW 480 L.T.A.R. .3

Septic Tank: 1000 Gallons; STB 1007 Date 3/24/05
Pump Tank: Gallons; PT Date
Pump Make: Model Serial No.
Nitrification Field: No Fields 1 Square Feet 1200 Linear Feet 400
No Lines 5@80' Trench Width 3' Max Trench Bottom Depth 3' Gravel Depth No

[X] New System ☐ Repair System Type: I, II, (III), IV, V, VI
System Description: GRAVITY - 25% REDUCED
Repair System Description: 483 RECORDING
Maintenance Agreement Required: ☐ Yes [X] No

[X] House/Mod. Home No. Bedrooms 4
☐ Mobile Home No. Bathrooms 3
☐ Business No. Employees
☐ Other
☐ Slab [X] Crawl Space ☐ Basement w/plumbing ☐ Basement wo/plumbing


Water Supply: [X] Individual ☐ Public ☐ Community

Comments:/Conditions:


Comments:/Conditions:

(1"=50')

INITIAL SITE SKETCH

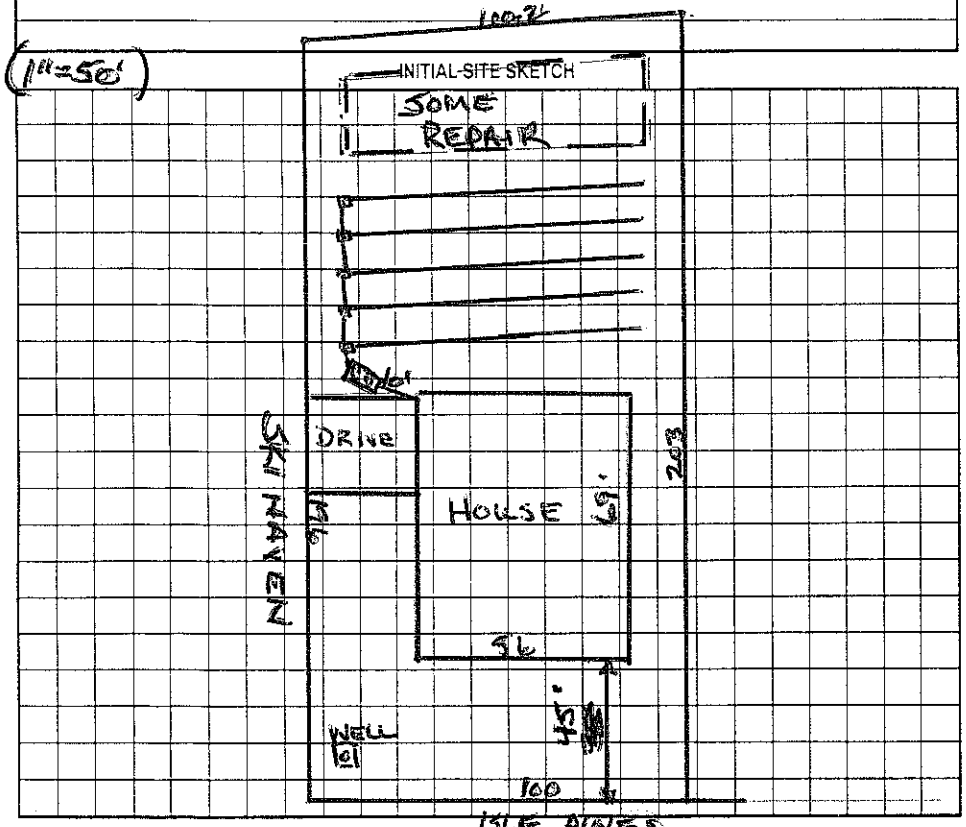

AS BUILT SKETCH

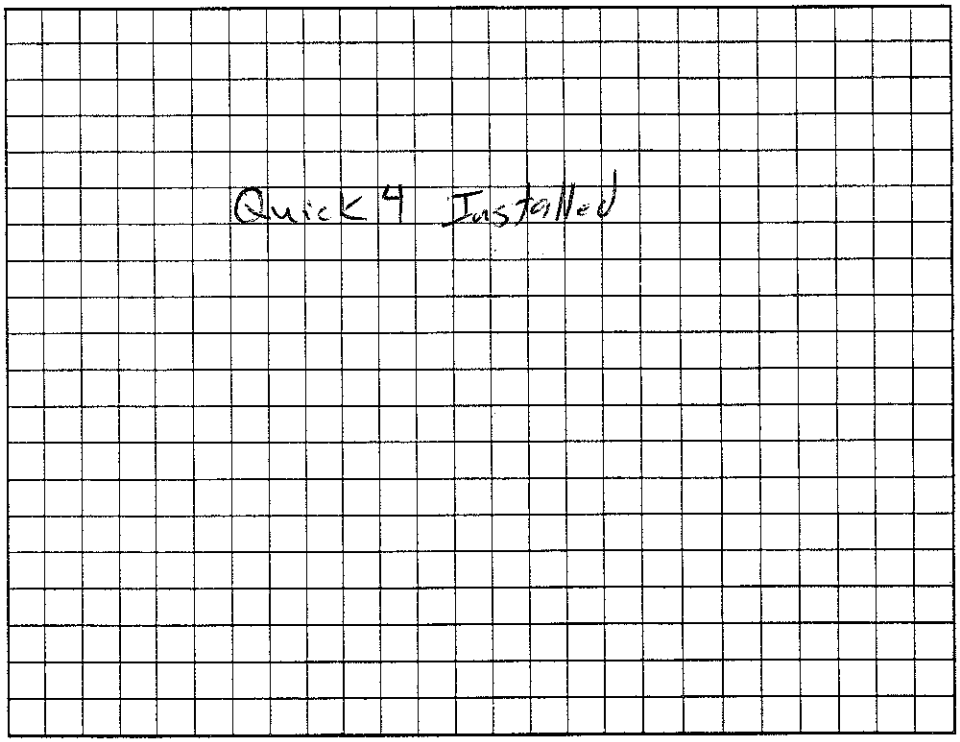

Permit can be suspended or revoked if any false information is supplied toward securing the permit/any unauthorized changes are made to the site/any unauthorized changes are made in the installation of the system. Improvement Permit with plat valid without expiration. Improvement Permit with site plan valid for sixty months. Authorization to Construct is valid for a period equal to that of Improvement Permit – not to exceed sixty months.

Signed: * date 10/21/04

Improvement Permit by: Wesley Sparks RS. date 10/15/04

Authorization to Construct by: Wesley Sparks RS. date 10/15/04

Installed by: Wayne Clontz

Operation Permit by: RS date 4/26/05

Existing System Inspection by: date

HEALTH DEPT. COPY: WHITE OWNER COPY (FINAL): YELLOW OWNER COPY (INITIAL): PINK