IREDELL COUNTY HEALTH DEPARTMENT

STATESVILLE 704-878-5305 MOORESVILLE 704-664-5281

IMPROVEMENT PERMIT / AUTHORIZATION TO CONSTRUCT / OPERATION PERMIT / EXISTING SYSTEM INSPECTION

PERMIT# 101679 PIN# 4635 38 2470.7 DATE 8/2/01

OWNER OR CONTRACTOR Watsview Homes and Land LLC PATRICK TOMPKINS 704-896-5158 Home

ADDRESS PO Box 3414 Mooresville, NC. 28117

LOCATION 1100 Tl side of Pines lot on (L) next to post B4 Ruby Rd.

SUBDIVISION Pineview BLOCK / SECTION LOT 7 LOT AREA ~1AC SITE CLASS. PS1 DESIGN FLOW 480 L.T.A.R. .3

Septic Tank: 1000 Gallons; STB 826 Date 2/10/06

Pump Tank: 1000 Gallons; PT 40 Date 2/24/06

Pump Make: Model Serial No.

Nitrification Field: No Fields 1 Square Feet 1200* Linear Feet 400*

No Lines 4@100' Trench Width 3' Max Trench Bottom Depth 3'

☒ New System ☐ Repair System Type: I, II, (III) IV, V, VI

System Description: PM → EZ LAY-CHAM. PLAS

Repair System Description: 16" PP BRS

Maintenance Agreement Required: ☐ Yes ☒ No

Gravel Depth NA

☒ House/Mod. Home No. Bedrooms 4

☐ Mobile Home No. Bathrooms 4

☐ Business No. Employees


☐ Other

☐ Slab ☒ Crawl Space ☐ Basement w/plumbing ☐ Basement wo/plumbing

Water Supply: ☒ Individual ☐ Public ☐ Community

Comments:/Conditions (1"=50') Large area assessed due to Topo.

INITIAL SITE SKETCH

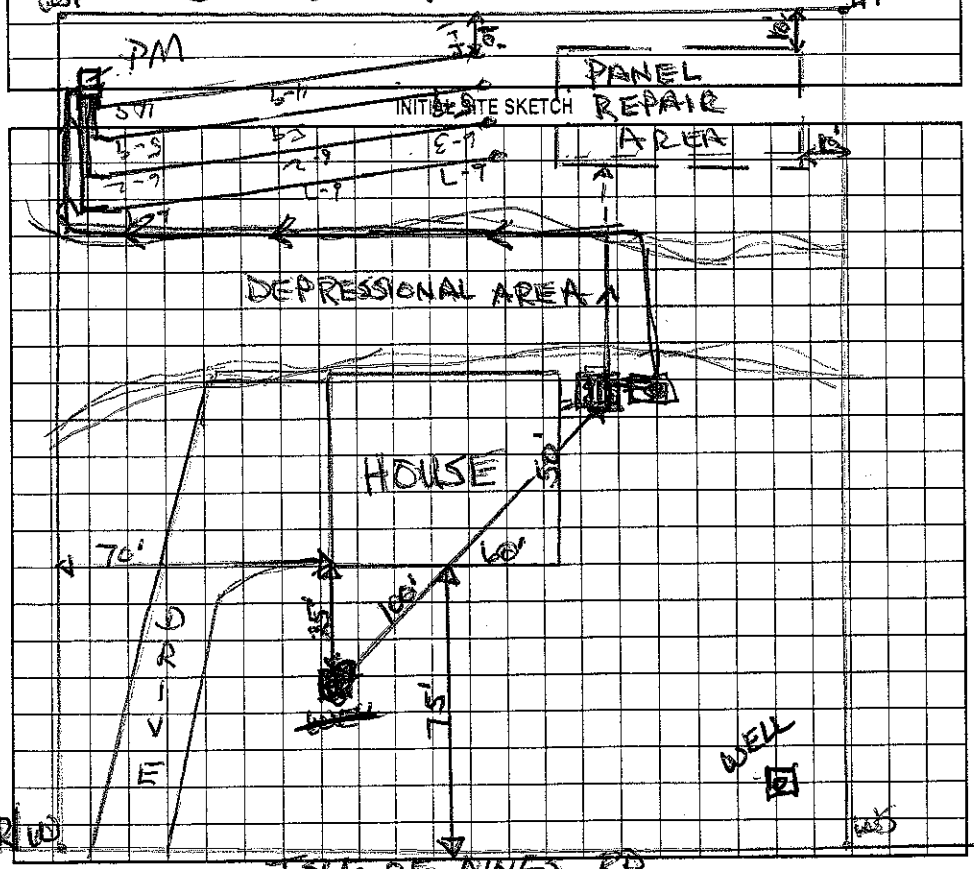

Comments:/Conditions: Tanks, Pm, Lines,

AS BUILT SKETCH

Permit can be suspended or revoked if any false information is supplied toward securing the permit/any unauthorized changes are made to the site/any unauthorized changes are made in the installation of the system. Improvement Permit with plat valid without expiration. Improvement Permit with site plan valid for sixty months. Authorization to Construct is valid for a period equal to that of Improvement Permit – not to exceed sixty months.

Signed: [signature] date

Improvement Permit by: Wesley Sparks R.S. date 8/2/01

Authorization to Construct by: Wesley Sparks R.S. date 12/5/05

Installed by: Ray Backhoe

Operation Permit by: Wesley Sparks RS date 7/31/06

Existing System Inspection by: date

HEALTH DEPT. COPY: WHITE OWNER COPY (FINAL): YELLOW OWNER COPY (INITIAL): PINK