IREDELL COUNTY HEALTH DEPARTMENT

STATESVILLE 704-878-5305 ⌀ MOORESVILLE 704-664-5281 3100

IMPROVEMENT PERMIT / AUTHORIZATION TO CONSTRUCT / OPERATION PERMIT / EXISTING SYSTEM INSPECTION

PERMIT# 105669 PIN# 4635-38-3250 DATE 12/14/05

OWNER OR CONTRACTOR Lyle Bjorgen PHONE: Business 704 400 9969 Home

ADDRESS 176 Elysian Dr Mooresville NC 28117

LOCATION BSR, TL Isle of Pines on LT on Corner with Ruby Rd

SUBDIVISION Pine View BLOCK / SECTION LOT 6 LOT AREA 1.02 AC SITE CLASS PS DESIGN FLOW 480 L.T.A.R. 0.3

Septic Tank: 1000 Gallons; STB 1007 Date 6/20/06
Pump Tank: 1000 Gallons; PT 274 Date 7/2/06
Pump Make: Model Serial No.
Nitrification Field: No Fields 1 Square Feet 1200 Linear Feet 400
No Lines 6@67' Trench Width 36" Max Trench Bottom Depth 36" Gravel Depth —

☒ New System ☐ Repair System Type: I, II, (III), IV, V, VI
System Description: Pump 25% Reduction
Repair System Description: LP Panel Block
Maintenance Agreement Required: ☐ Yes ☒ No

☒ House/Mod. Home ☐ Mobile Home ☐ Business ☐ Other
No. Bedrooms 4 No. Bathrooms No. Employees

☐ Slab ☐ Crawl Space ☒ Basement w/plumbing ☐ Basement wo/plumbing


Water Supply: ☒ Individual ☐ Public ☐ Community

Comments:/Conditions:

Some Repair

Comments:/Conditions:

INITIAL SITE SKETCH

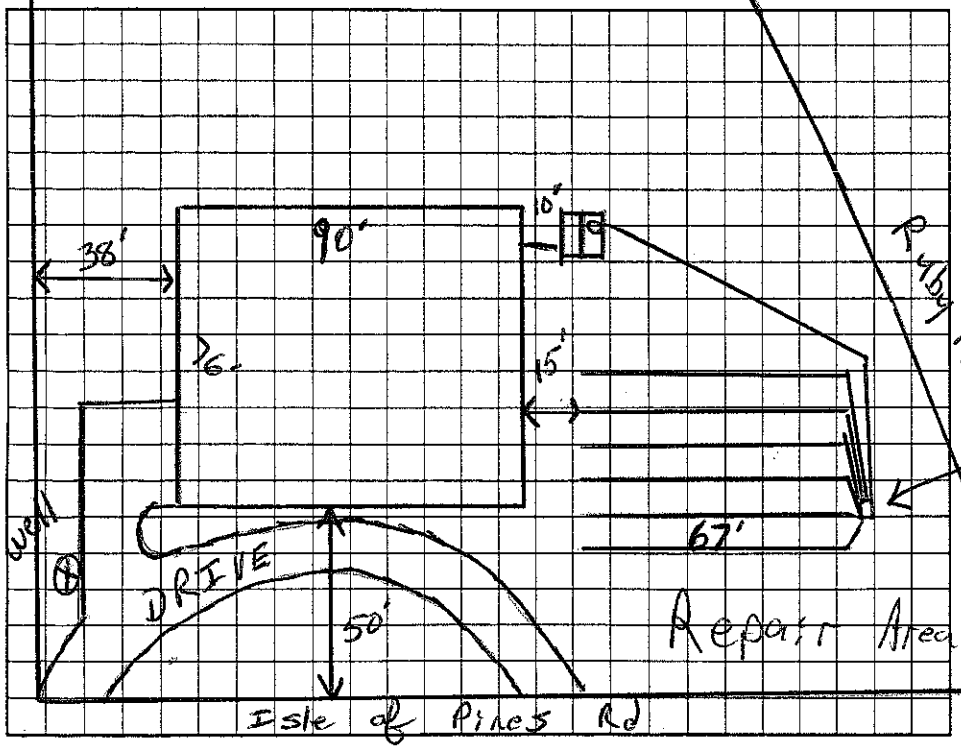

AS BUILT SKETCH

Permit can be suspended or revoked if any false information is supplied toward securing the permit/any unauthorized changes are made to the site/any unauthorized changes are made in the installation of the system. Improvement Permit with plat valid without expiration. Improvement Permit with site plan valid for sixty months. Authorization to Construct is valid for a period equal to that of Improvement Permit – not to exceed sixty months.

Signed: Kyle C. Bjorgen date 12/14/05 Installed by: Abernathy

Improvement Permit by: RS date 12/14/05 Operation Permit by: date 1/24/07

Authorization to Construct by: RS date 12/14/05 Existing System Inspection by: date

HEALTH DEPT. COPY: WHITE OWNER COPY (FINAL): YELLOW OWNER COPY (INITIAL): PINK