IREDELL COUNTY HEALTH DEPARTMENT

STATESVILLE 704-878-5305 MOORESVILLE 704-664-5281

IMPROVEMENT PERMIT / AUTHORIZATION TO CONSTRUCT / OPERATION PERMIT / EXISTING SYSTEM INSPECTION

DATE 6/1/00

PERMIT# 089464 PIN# 4635 38 3972

OWNER OR CONTRACTOR Kenneth Beeler PHONE: Business 662-6400 Home

ADDRESS 116 Malibu Rd Mooresville, NC. 28117

LOCATION 1100 Tl table of Pines, Tl Ruby Rd., 5th lot on (L)

SUBDIVISION PINEVIEW BLOCK / SECTION LOT 2 LOT AREA .91AC SITE CLASS. PS DESIGN FLOW 360 L.T.A.R. .3

Septic Tank: 1000 Gallons; STB 1012 Date 9/9/00

Pump Tank: Gallons; PT Date

Pump Make: Model 99' Serial No.

Nitrification Field: No Fields 1 Square Feet 1200 Linear Feet 400

No Lines 5@20'x3' Trench Width 36" Max Trench Bottom Depth 36" 48" Gravel Depth SAND

[X] New System [ ] Repair System Type: I, II, (III), IV, V, VI

System Description: GRAVITY - HOS or CH. PLASTIC

Repair System Description: Pressure - HOS or CH PLAS

Maintenance Agreement Required: [ ] Yes [X] No

[X] House/Mod. Home [ ] Mobile Home [ ] Business [ ] Other

No. Bedrooms 3 No. Bathrooms 2.5 No. Employees

[ ] Slab [X] Crawl Space [ ] Basement w/plumbing [ ] Basement wo/plumbing

Water Supply: [X] Individual [ ] Public [ ] Community

Comments:/Conditions:


Pressure
Repair
Dwen

Comments:/Conditions:

Chambered Plastic installed

INITIAL SITE SKETCH

(1"=50')

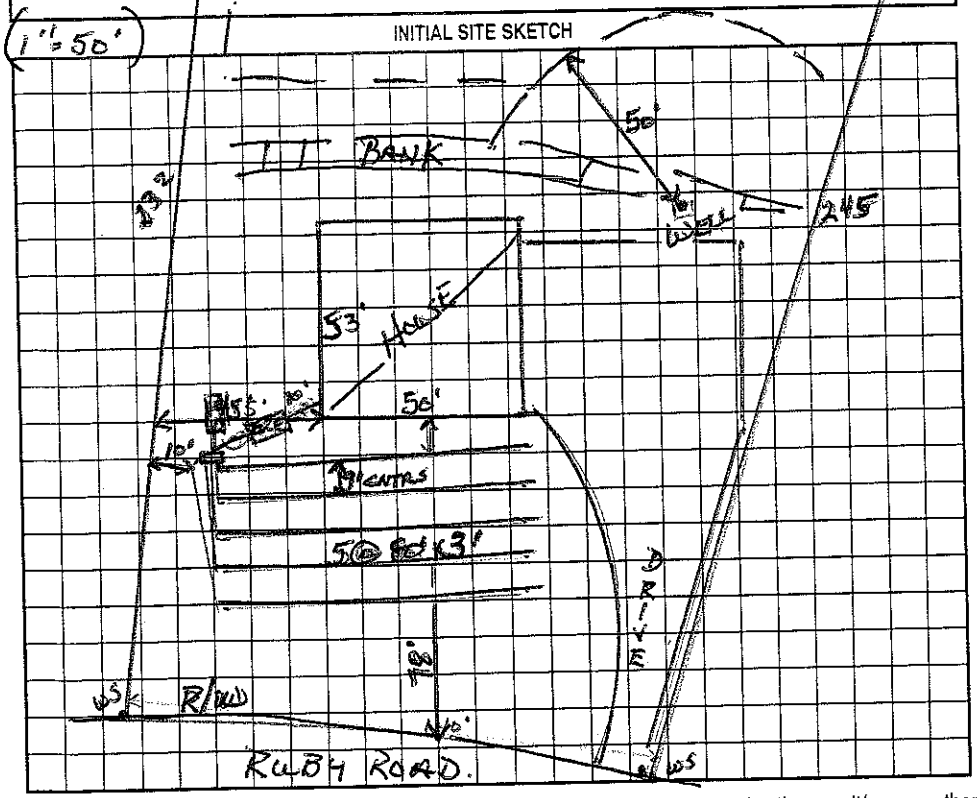

AS BUILT SKETCH

Permit can be suspended or revoked if any false information is supplied toward securing the permit/any unauthorized changes are made to the site/any unauthorized changes are made in the installation of the system. Improvement Permit with plat valid without expiration. Improvement Permit with site plan valid for sixty months. Authorization to Construct is valid for a period equal to that of Improvement Permit – not to exceed sixty months.

Signed: * date 6/2/00

Improvement Permit by: Wesley Sparks RS. date 6/01/00

Authorization to Construct by: Wesley Sparks RS date 6/01/00

Installed by: Steve Jordan

Operation Permit by: Wesley Sparks RS. date 11/22/00

Existing System Inspection by: date

HEALTH DEPT. COPY: WHITE OWNER COPY (FINAL): YELLOW OWNER COPY (INITIAL): PINK