IREDELL COUNTY HEALTH DEPARTMENT

STATESVILLE 704-878-5305 MOORESVILLE 704-664-5281

IMPROVEMENT PERMIT / AUTHORIZATION TO CONSTRUCT / OPERATION PERMIT / EXISTING SYSTEM INSPECTION

PERMIT # 153687 PIN # 4635390427 DATE 11-21-08

OWNER or APPLICANT Bradley Custom Builders LLC PHONE: Business Cell 201-2291 Home: 799-6394

OWNER or APPLICANT ADDRESS 129 Honeysuckle Ln Mooresville NC 28117

LOCATION / DIRECTIONS Brawley School Rd TL Isle of Pines TL Lake Hills Dr on right

SUBDIVISION Lake Hills Est BLOCK / SECTION LOT # 13 LOT AREA DESIGN FLOW 480 gpd L.T.A.R. 0.3

Existing

Septic Tank 1600 Gallons: STB Date

Pump Tank Gallons: PT Date

Pump Make Model Serial #

Nitrification Field No Fields 1 No Lines 5 Linear Feet 400'

Trench Width ~~36~~ 36" Max. Trench Bottom Depth 36" Gravel Depth N/A

☐ New System ☐ Repair ☐ Expansion System Type I II III IV V VI

System Description: Existing Gravity - 25% Reduction

Repair System Description: Pump - Panel Blk.

Maintenance Agreement Required ☐ YES ☐ NO

☐ GRAVITY ☐ PRESSURE

☒ Residence No. Bedrooms 4

☐ Business No. Persons

☐ Other No. Employees

☐ Slab ☐ Crawl Space

☐ Basement w/plumbing ☐ Basement w/o plumbing


Water Supply: ☒ Private ☐ Public ☐ Community

Comments / Conditions: Existing System appears to be Functioning Okay at time of inspection


Comments / Conditions: Must Keep Deck Addition at least 5 Ft from Septic System.

System Originally installed 3/13/06

INITIAL SITE SKETCH

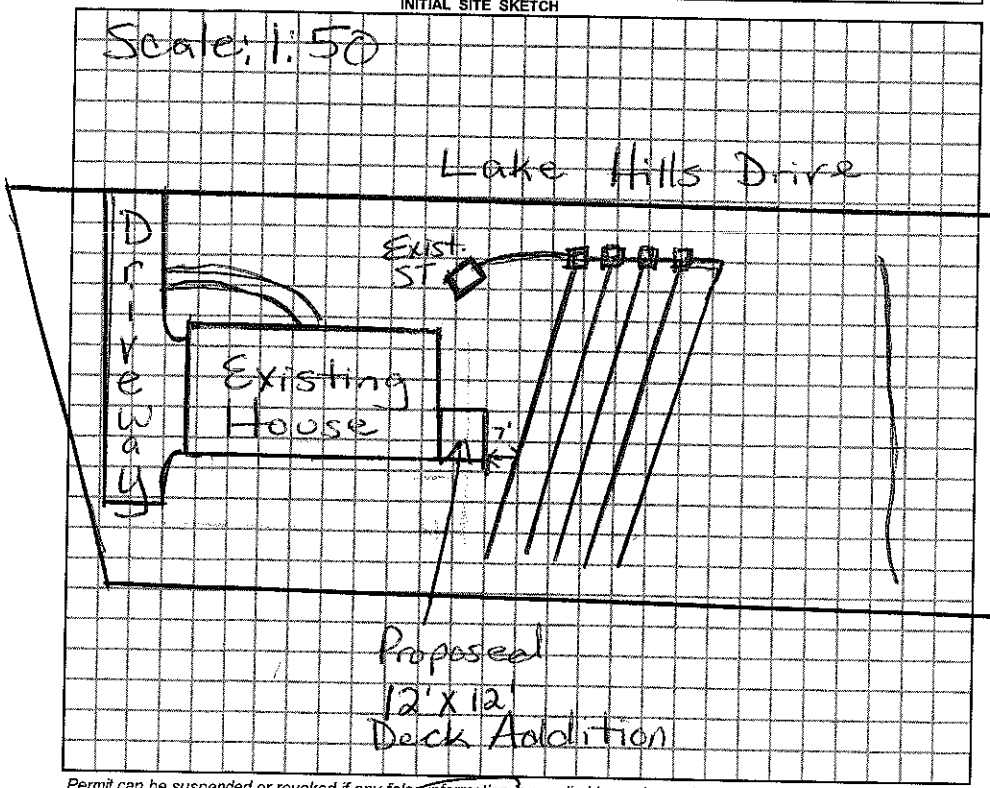

AS BUILT SKETCH

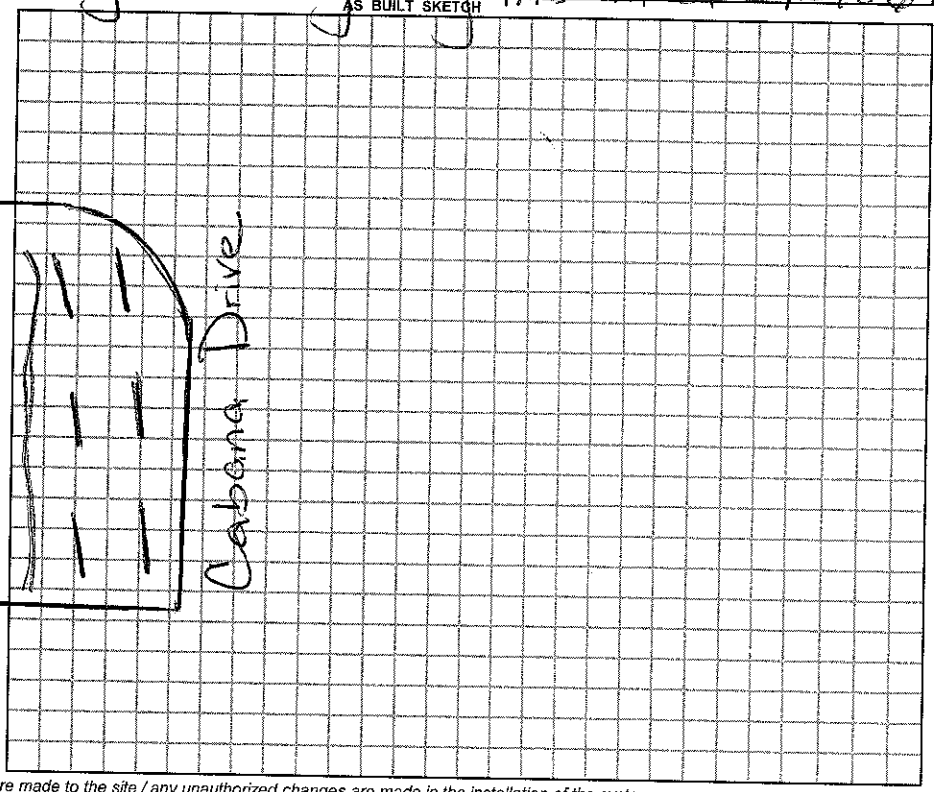

Permit can be suspended or revoked if any false information is supplied toward securing the permit / any unauthorized changes are made to the site / any unauthorized changes are made in the installation of the system.

☐ *IMPROVEMENT PERMIT w / plat valid without expiration.* ☐ *IMPROVEMENT PERMIT w / site plan valid for 60 mos.* ☐ *AUTHORIZATION TO CONSTRUCT valid for period equal to IMPROVEMENT PERMIT-not to exceed 60 mo.*

Owner / Applicant Signature: Date 11-27-08

Improvement Permit by: RS Date 11-21-08

Authorization to Construct by: RS Date 11-21-08

YOU SHOULD CONTACT A LOCATOR SERVICE PRIOR TO ANY EXCAVATION.

Installed by:

Operation Permit by: Date:

Existing System Inspected by: RS Date: 11/21/08

WHITE COPY Environmental Health YELLOW COPY (Final) Owner / Applicant PINK COPY (Initial) Owner / Applicant