IREDELL COUNTY HEALTH DEPARTMENT

LE 704-878-5305 MOORESVILLE 704-664-5281

IMPROVEMENT PERMIT / AUTHORIZATION TO CONS UCT / OPERATION PERMIT / EXISTING SYSTEM INSPECTIO

500.00 tank

PERMIT# 075211 PIN# 4636 30 7807 DATE 12/20/02

OWNER OR CONTRACTOR Mark Dull Const. PHONE: Business 704-202-5348 Home

ADDRESS PO Box 618 Mt. Ulla NC 28125

LOCATION Brawley Sch, TL Isle of Pines, TL Lake Hills (across from Waterfold) on 4th Street

SUBDIVISION Lake Hills Est. BLOCK / SECTION F LOT 3 LOT AREA 0.71 AC SITE CLASS PS DESIGN FLOW 480 L.T.A.R. 0.5

Septic Tank: 1000 Gallons: STB Date

Pump Tank: Gallons: PT Date

Pump Make: Model Serial No.

Nitrification Field: No Fields 1 Square Feet 1200 Linear Feet 400

No Lines 3@153' Trench Width 36" Max Trench Bottom Depth 36" Gravel Depth —

☒ New System ☐ Repair System Type: I, II, III, IV, V, VI

System Description: Gravity 25% Reduction

Repair System Description: Same

Maintenance Agreement Required: ☐ Yes ☐ No

☒ House/Mod. Home ☐ Mobile Home ☐ Business ☐ Other

No. Bedrooms 4 No. Bathrooms 2½ No. Employees


☐ Slab ☒ Crawl Space ☐ Basement w/plumbing ☐ Basement wo/plumbing

Water Supply: ☒ Individual ☐ Public ☐ Community


Comments:/Conditions:

Comments:/Conditions:

INITIAL SITE SKETCH 1" = 50'

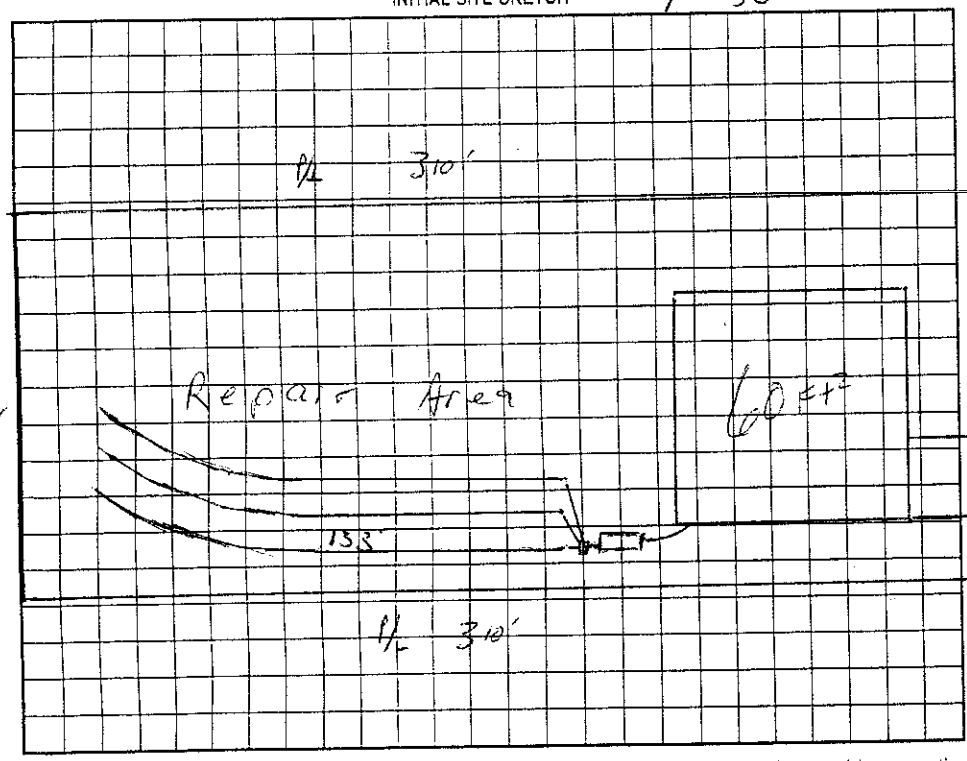

AS BUILT SKETCH

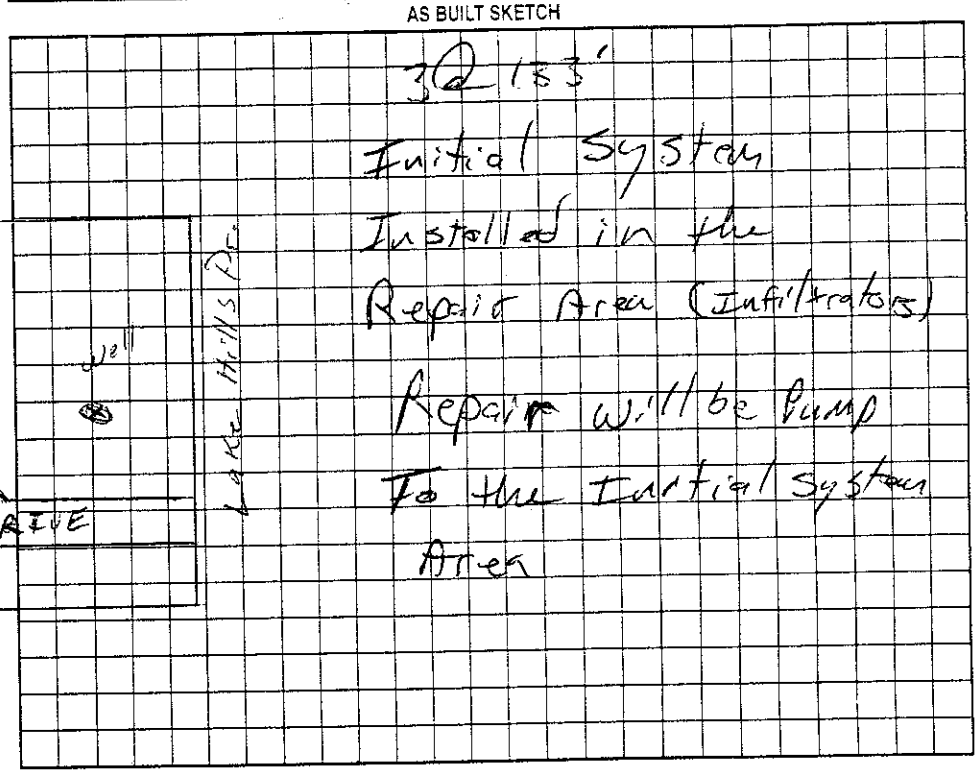

Permit can be suspended or revoked if any false information is supplied toward securing the permit/any unauthorized changes are made to the site/any unauthorized changes are made in the installation of the system. Improvement Permit with plat valid without expiration. Improvement Permit with site plan valid for sixty months. Authorization to Construct is valid for a period equal to that of Improvement Permit – not to exceed sixty months

Signed: date 12-27-02 Installed by: Rowan Septic

Improvement Permit by: RS date 12/20/02 Operation Permit by: RS date 4/30/03

Authorization to Construct by: RS date 12/20/02 Existing System Inspection by: date

HEALTH DEPT. COPY: WHITE OWNER COPY (FINAL): YELLOW OWNER COPY (INITIAL): PINK