IREDELL COUNTY HEALTH DEPARTMENT

STATESVILLE 704-878-5305 MOORESVILLE 704-664-5281

As Built

IMPROVEMENT PERMIT / AUTHORIZATION TO CONSTRUCT / OPERATION PERMIT / EXISTING SYSTEM INSPECTION

PERMIT# 121478 PIN# 4636307807 DATE 3-10-06

OWNER OR CONTRACTOR Carolina Builders PHONE: Business Home

ADDRESS

LOCATION

SUBDIVISION Lakehills Est BLOCK / SECTION LOT 4 LOT AREA 1.08 Acre SITE CLASS. PS DESIGN FLOW 480gpd L.T.A.R. .3

Septic Tank: 1000 Gallons; STB 1012 Date 6-20-05
Pump Tank: 1000 Gallons; PT 17 Date 10-3-05
Pump Make: Goulds Model WE0311M Serial No.
Nitrification Field: No Fields 1 Square Feet Linear Feet
No Lines 4@100 Trench Width Max Trench Bottom Depth Gravel Depth

☒ New System ☐ Repair System Type: I, II, III, IV, V, VI
System Description: Pump-PM-25% Reduction
Repair System Description: Bear/Pump Innovative
Maintenance Agreement Required: ☐ Yes ☒ No


☒ House/Mod. Home No. Bedrooms 4
☐ Mobile Home No. Bathrooms
☐ Business No. Employees
☐ Other
☐ Slab ☐ Crawl Space ☐ Basement w/plumbing ☐ Basement wo/plumbing

Water Supply:
☒ Individual
☐ Public
☐ Community


Comments:/Conditions:

Comments:/Conditions:

Scale 1:50 INITIAL SITE SKETCH

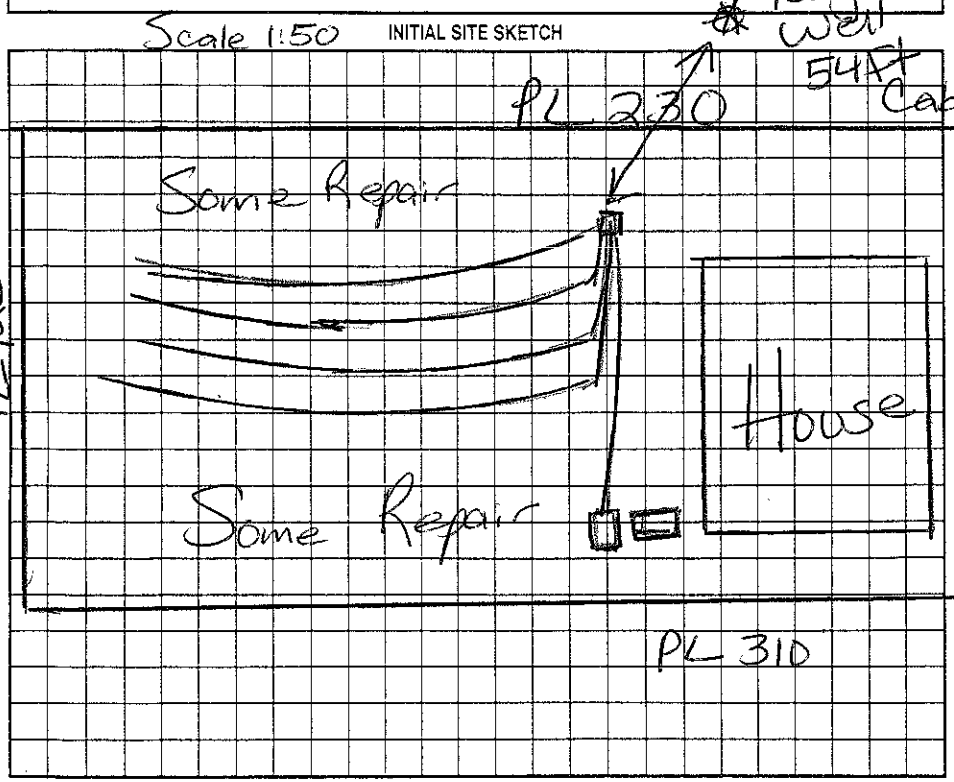

AS BUILT SKETCH

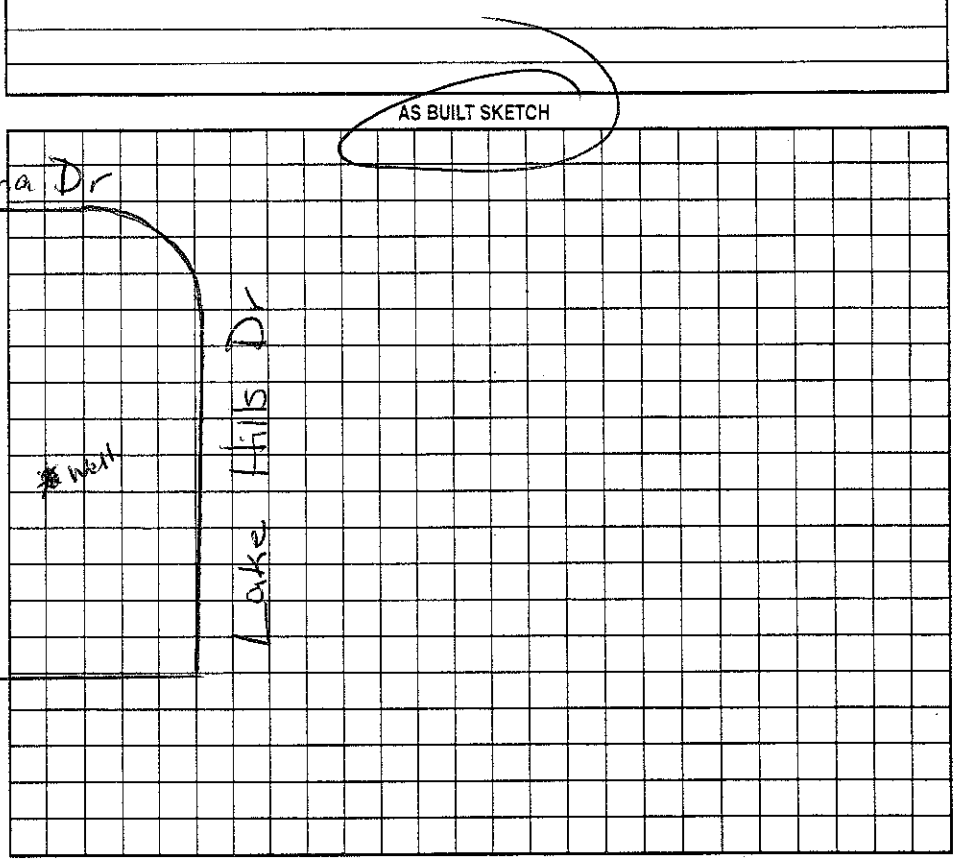

Permit can be suspended or revoked if any false information is supplied toward securing the permit/any unauthorized changes are made to the site/any unauthorized changes are made in the installation of the system. Improvement Permit with plat valid without expiration. Improvement Permit with site plan valid for sixty months. Authorization to Construct is valid for a period equal to that of Improvement Permit – not to exceed sixty months.

Signed: date Installed by:

Improvement Permit by: date Operation Permit by: date

Authorization to Construct by: date Existing System Inspection by: date

HEALTH DEPT. COPY: WHITE OWNER COPY (FINAL): YELLOW OWNER COPY (INITIAL): PINK