131478

# IREDELL COUNTY HEALTH DEPARTMENT

STATESVILLE 704-878-5305 155.00 Paid MOORESVILLE 704-664-5281

3:15

## IMPROVEMENT PERMIT / AUTHORIZATION TO CONSTRUCT / OPERATION PERMIT / EXISTING SYSTEM INSPECTION

PERMIT# 075212 PIN# 4635307807 Taylor Builders 4635-39-1751 DATE 10/30/02

OWNER OR CONTRACTOR Easter Develop Corp. PHONE: Business 201-6465 Home

ADDRESS 227 Hideaway Ln Mooresville, NC 28117

LOCATION Brawley School Rd TL Isle of Pines TL Lakehills Dr on left at Cabana

SUBDIVISION Lakehills Est BLOCK / SECTION LOT 4 LOT AREA 1.084ere SITE CLASS PS DESIGN FLOW 480gpd L.T.A.R. .3

Septic Tank: 1000 Gallons: STB 1012 Date 6-20-05
Pump Tank: 1000 Gallons: PT 1.7 Date 10-3-05
Pump Make: Goulds Model WE0311M Serial No.
Nitrification Field: No Fields 1 Square Feet 1200' Linear Feet 480'
No Lines 4@100' Trench Width 36" Max Trench Bottom Depth 36" Gravel Depth N/A

X New System * ☐ Repair System Type: I II III IV V VI
System Description: Gravity-25% Reduction
Repair System Description: Grav/Pump - Innovative
Maintenance Agreement Required: ☑ Yes ☐ No

X House/Mod. Home ☐ Mobile Home ☑ Business ☐ Other
No. Bedrooms 4 No. Bathrooms 3 No. Employees


☐ Slab X Crawl Space ☐ Basement w/plumbing ☐ Basement wo/plumbing

Water Supply: X Individual ☐ Public ☐ Community


Comments/Conditions: Keep Septic System at least 10' From PL, Slope area over Drainfield towards Lot 3 & 4 property line (PL)

Comments/Conditions: *Note: Crawl space must be high enough & plumbing stubbed out high to maintain gravity flow otherwise Septic must be pumped!

INITIAL SITE SKETCH Scale 1:50

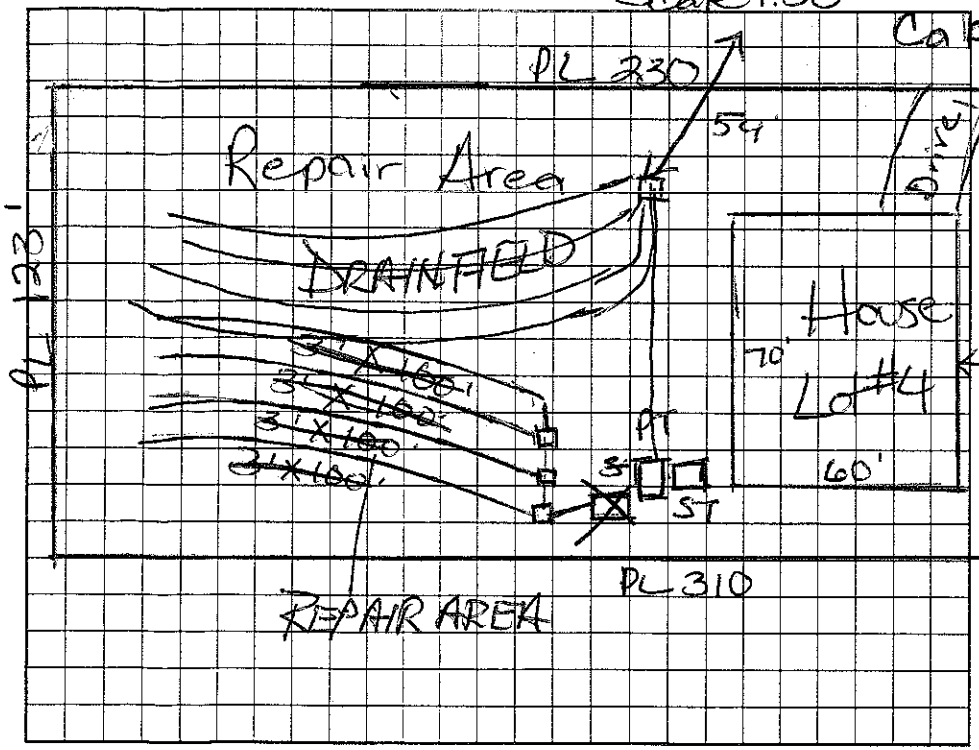


AS BUILT SKETCH

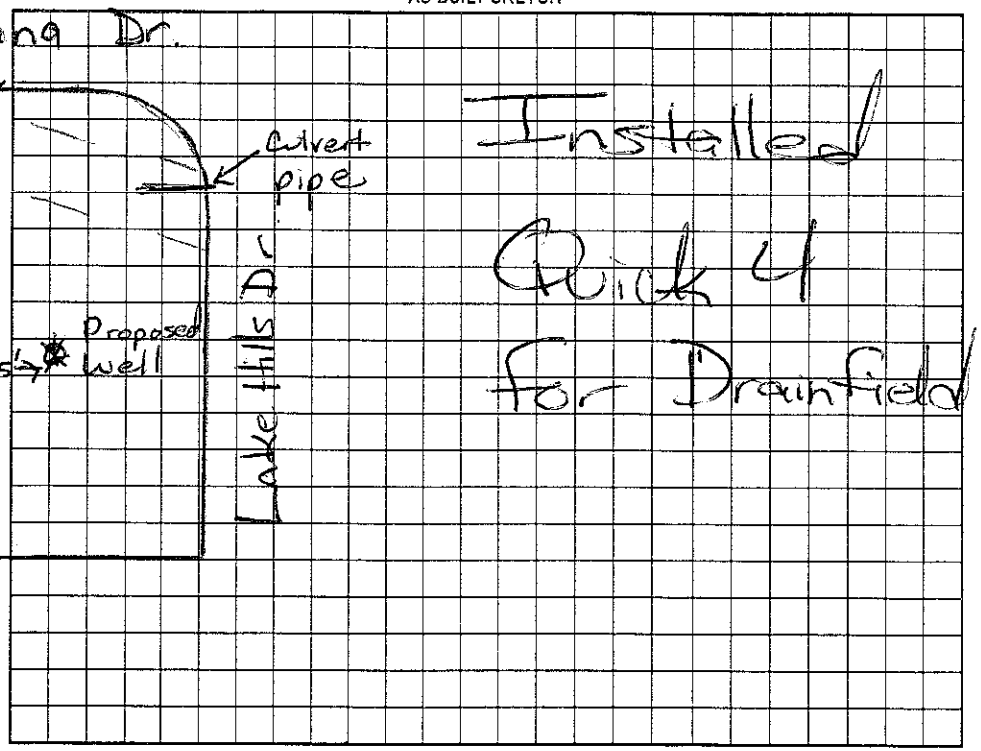


Permit can be suspended or revoked if any false information is supplied toward securing the permit/any unauthorized changes are made to the site/any unauthorized changes are made in the installation of the system. Improvement Permit with plat valid without expiration. Improvement Permit with site plan valid for sixty months. Authorization to Construct is valid for a period equal to that of Improvement Permit – not to exceed sixty months.

Signed: date 10/31/02 Installed by: C & S Grading

Improvement Permit by: Mina H. Doban R.S. date 10/30/02 Operation Permit by: date 6/1/06

Authorization to Construct by: RS date 2/17/05 Existing System Inspection by: date

HEALTH DEPT. COPY: WHITE OWNER COPY (FINAL): YELLOW OWNER COPY (INITIAL): PINK