IREDELL COUNTY HEALTH DEPARTMENT

STATESVILLE 704-8[illegible] 130.00 Pg 9 MOORESVILLE 704-664-5281

IMPROVEMENT PERMIT / AUTHORIZATION TO CONSTRUCT / OPERATION PERMIT / EXISTING SYSTEM INSPECTION

PERMIT# 11433 PIN# 4635-39-3162 DATE 8/21/03

OWNER OR CONTRACTOR Kimberly James Evans PHONE: Business 704 201 0658 Home

ADDRESS PO Box 891 Davidson NC 28036

LOCATION BSR, TL Isle of Pines, TL Ruby Rd, on Lt.

SUBDIVISION Pine View BLOCK / SECTION LOT 1 LOT AREA 1.20 Ac SITE CLASS PS DESIGN FLOW 480 L.T.A.R. 0.5

Septic Tank: 1000 Gallons; STB 312 Date 4/14/04

Pump Tank: 1000 Gallons; PT 27 Date 4/14/04

Pump Make: Gould's Model WE07T2HH Serial No.

Nitrification Field: No Fields 1 Square Feet 1200 Linear Feet 400

No Lines 6@67' Trench Width 36" Max Trench Bottom Depth 36" Gravel Depth —

☒ New System ☐ Repair System Type: I, II, (III) IV, V, VI

System Description: Pressure Min. 25% Red

Repair System Description: LP Panel Block

Maintenance Agreement Required: ☐ Yes ☒ No

☒ House/Mod. Home ☐ Mobile Home ☐ Business ☐ Other

No. Bedrooms 4 No. Bathrooms 3 No. Employees


Water Supply: ☒ Individual ☐ Public ☐ Community

☐ Slab ☒ Crawl Space ☐ Basement w/plumbing ☐ Basement wo/plumbing


Comments:/Conditions:

Comments:/Conditions:

INITIAL SITE SKETCH

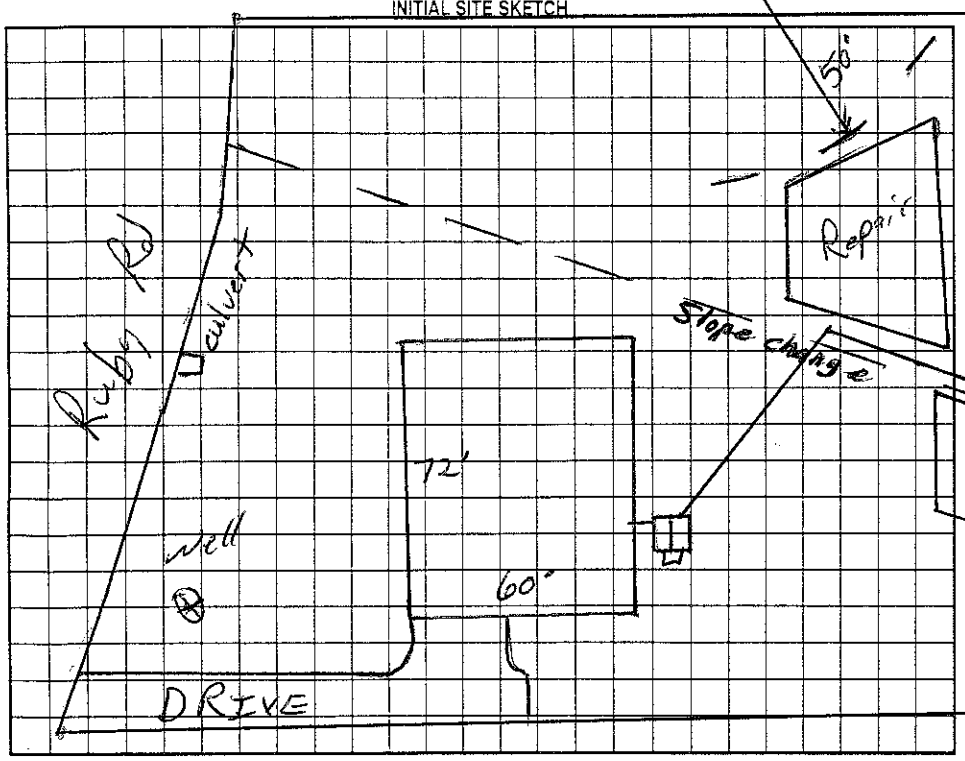

AS BUILT SKETCH

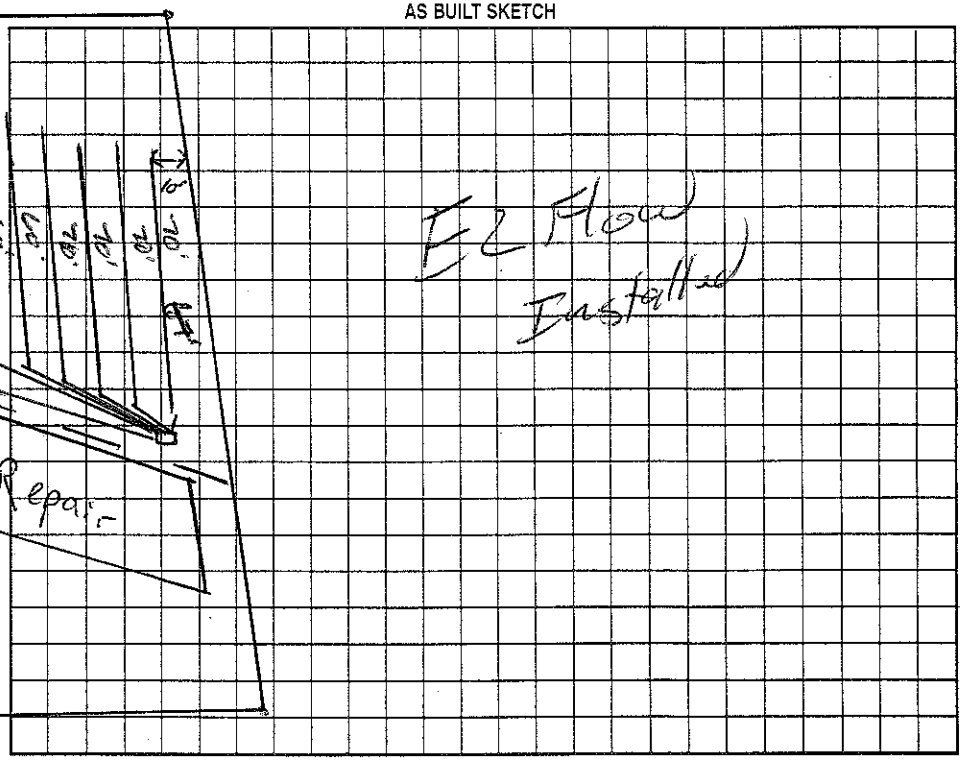

Permit can be suspended or revoked if any false information is supplied toward securing the permit/any unauthorized changes are made to the site/any unauthorized changes are made in the installation of the system. Improvement Permit with plat valid without expiration. Improvement Permit with site plan valid for sixty months. Authorization to Construct is valid for a period equal to that of Improvement Permit – not to exceed sixty months.

Signed: [signature] date 4/28/04 Installed by: Charles Rosemon

Improvement Permit by: [signature] RS date 8/21/03 Operation Permit by: [signature] RS date 5/24/04

Authorization to Construct by: [signature] RS date 8/21/03 Existing System Inspection by: date

HEALTH DEPT. COPY: WHITE OWNER COPY (FINAL): YELLOW OWNER COPY (INITIAL): PINK