DELL COUNTY HEALTH DEPARTMENT

STATESVILLE 704-878-5305 MOORESVILLE 704-664-5281

155.00 Paid Cody 704 902-9857 2.00

IMPROVEMENT PERMIT / AUTHORIZATION TO CONSTRUCT / OPERATION PERMIT / EXISTING SYSTEM INSPECTION

PERMIT# 075216 PIN# ~~4636301807 PF~~ (704) 4635-39-4417 DATE 11-19-02

OWNER OR CONTRACTOR Atkinson Custom Homes PHONE: Business 506-9074 Home

ADDRESS 490 River Ridge Ln. Lexington NC 27295

LOCATION Brawley School Rd TL Isle of Pines TL Lake Hills Estate TR Cabana Dr. 1st on left.

SUBDIVISION Lakehills Est. BLOCK / SECTION LOT 8 LOT AREA .74 Acre SITE CLASS. PS DESIGN FLOW 360gpd L.T.A.R. .3

Septic Tank: 1000 Gallons; STB 1007 Date 3-17-03
Pump Tank: Gallons; PT Date
Pump Make: Model Serial No.
Nitrification Field: No Fields 1 Square Feet 1200' Linear Feet 400'
No Lines 5@80' Trench Width 36" Max Trench Bottom Depth ~~20"~~ 36" Gravel Depth N/A

☒ New System ☐ Repair System Type: I. II. III. IV. V. VI
System Description: Gravity - 25% Reduction
Repair System Description: Same
Maintenance Agreement Required: ☐ Yes ☒ No


☒ House/Mod. Home No. Bedrooms 4
☐ Mobile Home No. Bathrooms 2
☐ Business No. Employees
☐ Other
☐ Slab ☒ Crawl Space ☐ Basement w/plumbing ☐ Basement wo/plumbing

Water Supply: ☒ Individual ☐ Public ☐ Community


Comments/Conditions: Keep Septic System at least 10' From PL & 100' From well

Comments/Conditions: 5/12/03 Evaluated Backhoe pit revised trench depth = 36" *Okay to use 4 drop boxes" Tank marker & filter installed

INITIAL SITE SKETCH Scale 1:50'

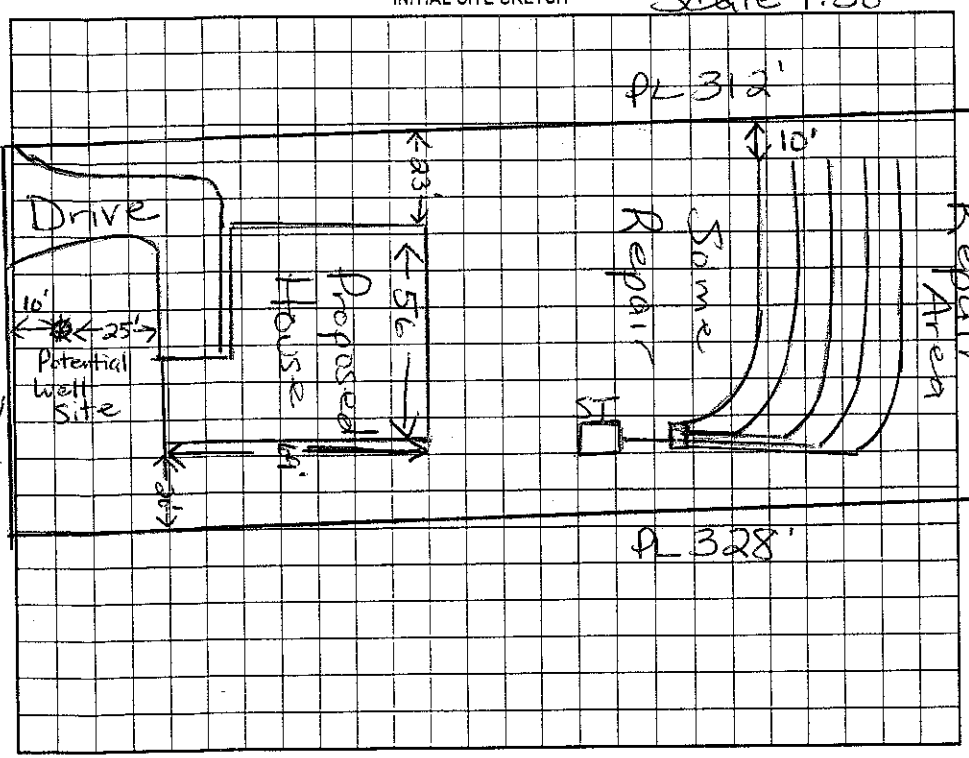

AS BUILT SKETCH

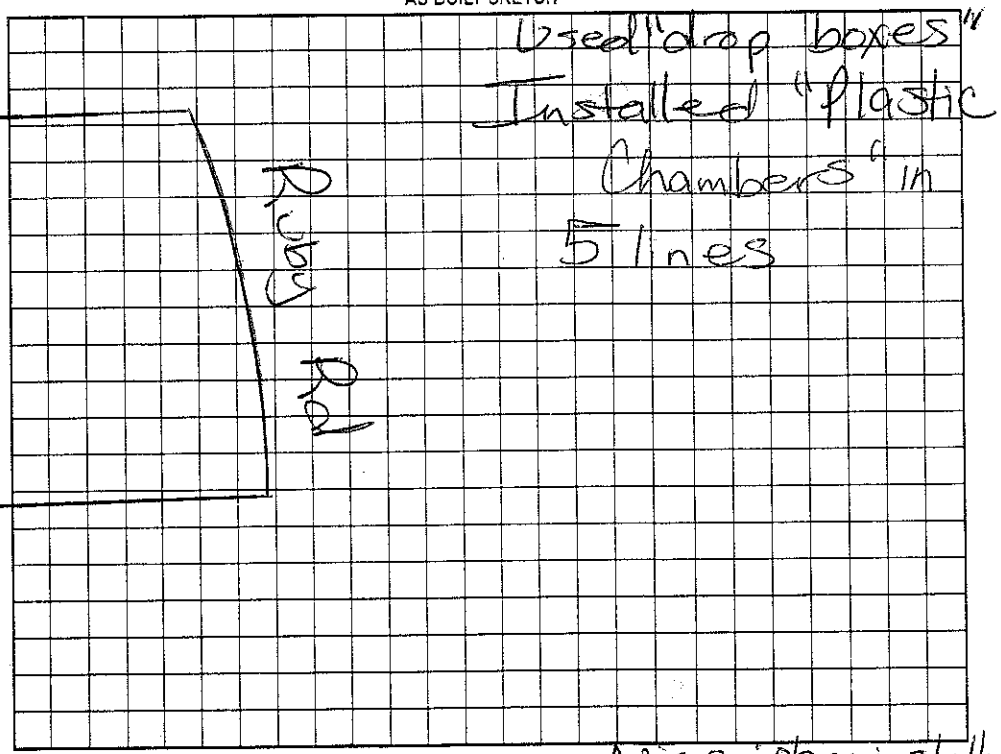

Nice job on installation

Permit can be suspended or revoked if any false information is supplied toward securing the permit/any unauthorized changes are made to the site/any unauthorized changes are made in the installation of the system. Improvement Permit with plat valid without expiration. Improvement Permit with site plan valid for sixty months. Authorization to Construct is valid for a period equal to that of Improvement Permit – not to exceed sixty months.

Signed: date 11/20/02 Installed by: Travis Enterprises Inc.

Improvement Permit by: Maria H. Dotson RS date 11/19/2002 Operation Permit by: Maria H. Dotson RS date 5/15/03

Authorization to Construct by: Maria H. Dotson RS date 11/19/2002 Existing System Inspection by: date

HEALTH DEPT. COPY: WHITE OWNER COPY (FINAL): YELLOW OWNER COPY (INITIAL): PINK