IREDELL COUNTY HEALTH DEPARTMENT

STATESVILLE 704-878-5305 155.00 Paid MOORESVILLE 704-664-5281 2.00

IMPROVEMENT PERMIT / AUTHORIZATION TO CONSTRUCT / OPERATION PERMIT / EXISTING SYSTEM INSPECTION

PERMIT# 075214 PIN# ~~4636307807~~ PT 4635-39-4609 DATE 11-21-2002

OWNER OR CONTRACTOR Atkinson Custom Homes PHONE: Business 7045069074 Home

ADDRESS 490 River Ridge Ln Lexington, NC. 27295

LOCATION Brawley School Rd TL ~~Rt~~ Isle of Pines TL Lake Hills Estates TL Cabana lot on right

SUBDIVISION Lake Hills Est. BLOCK / SECTION LOT 6 LOT AREA SITE CLASS. PS DESIGN FLOW 480gpd L.T.A.R. .3

Septic Tank: 1000 Gallons; STB 1007 Date 3-4-03
Pump Tank: Gallons; PT Date
Pump Make: Model Serial No.
Nitrification Field: No Fields 1 Square Feet 1200' Linear Feet 400'
No Lines 4@100' Trench Width 36" Max Trench Bottom Depth 36" Gravel Depth N/A

☒ New System ☐ Repair System Type: I. II. III. IV. V. VI
System Description: Gravity-25% Reduction
Repair System Description: ~~Gravity~~ - Innovative
Maintenance Agreement Required: ☐ Yes ☒ No

☒ House/Mod. Home ☐ Mobile Home ☐ Business ☐ Other
No. Bedrooms 4 No. Bathrooms 2.5 No. Employees
☐ Slab ☐ Crawl Space ☐ Basement w/plumbing ☐ Basement wo/plumbing


Water Supply: ☒ Individual ☐ Public ☐ Community

Comments:/Conditions: Keep Septic System at least 10' From PL & 100' to well

Comments:/Conditions: ~~X~~ Okay to install 3 lines @ 133' if it can be installed on Contour
*Blue filter installed @ tank marker

Scale 1:50'

INITIAL SITE SKETCH

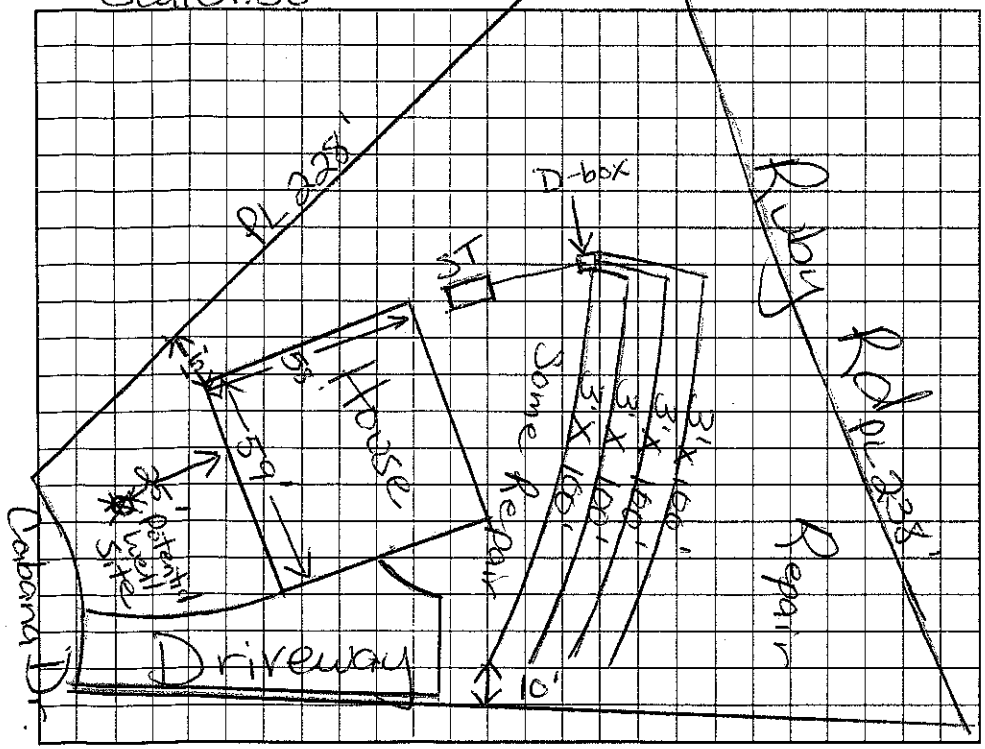

AS BUILT SKETCH

Installed 4 Plastic Chambers for Drainfield
13 3 lines 133' ea

Permit can be suspended or revoked if any false information is supplied toward securing the permit/any unauthorized changes are made to the site/any unauthorized changes are made in the installation of the system. Improvement Permit with plat valid without expiration. Improvement Permit with site plan valid for sixty months. Authorization to Construct is valid for a period equal to that of Improvement Permit – not to exceed sixty months.

Signed: date 11/21/02 Installed by: Travis Enterprises

Improvement Permit by: Maria H. Dotson RS date 11/21/2002 Operation Permit by: Maria H. Dotson RS date 4/30/03

Authorization to Construct by: Maria H. Dotson RS date 11/21/2002 Existing System Inspection by: date

HEALTH DEPT. COPY: WHITE OWNER COPY (FINAL): YELLOW OWNER COPY (INITIAL): PINK